


Jackson
N 180
4-67

MISSISSIPPI
BOARD OF WATER COMMISSIONERS
416 North State Street
Jackson, Mississippi 39201

WATER WELL DRILLERS LOG

4-27 1967 date well completed
Switzer Well Co. firm name
Jackson county well located


LANDOWNER: FIRST FEDERAL SAVINGS + LOAN Co.	description of formations encountered	from	to
MOBILE ALA. (mailing address)	clay	0	32
	sand	32	42
	clay	42	46
	sand	46	72
	clay	72	83
WELL LOCATION: sec. 13 T 7 N R 9 E 3 miles NW of OCEAN SPRINGS	clay + sand streaks	83	103
	clay	103	118
	fine sand	118	123
	clay	123	200
WELL PURPOSE: home! (home, irrigation, municipal, industrial)	sand	200	205
	medium sand	205	227
WELL COMPLETION DATA:			
(1) diameter (inches) 2			
(2) total depth (feet) 225			
(3) static water level (feet) 6 below top of ground.			
(4) casing gal steel 2 1/2" (material) 215' (depth)			
2" (size) if telescope see back.			
(5) screen 10' (length) 215' (depth to top)			
8ga. ss on pipe (size) (material)			
(6) pump 1/3 (HP) 5 (yield gpm)			
ELEC. (type power)			
(7) electric log No (yes or no)			
(organization running log)			
(8) how well bottom plugged back pressure valve			
DRILLERS REMARKS:			

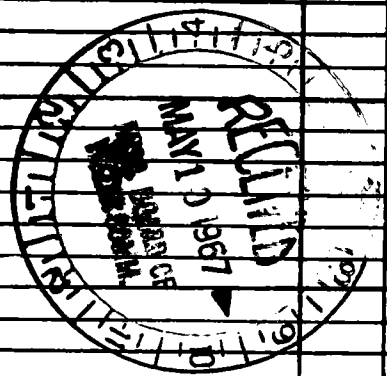

If well telescopes please sketch and show depths.

GROUND LEVEL

NW NE

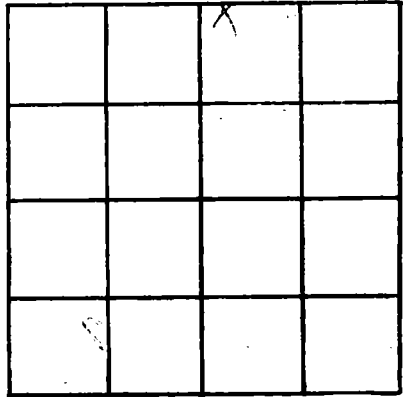

SECTION 13

Please indicate well location X.

ADDITIONAL INFORMATION

If more than one screen, show locations of each on sketch.