

Jackson  
 N182  
 5-67

MISSISSIPPI  
 BOARD OF WATER COMMISSIONERS  
 416 North State Street  
 Jackson, Mississippi 39201

WATER WELL DRILLERS LOG

45 5-18 1967 Switzer Shell Co. Jackson  
 date well completed firm name county well located

LANDOWNER: Sam Hamburg  
East of Highway 90  
Davis Bryon Sub. Lot 6. o.s.  
2 Davis Blvd. Ocean Springs  
 (mailing address)

description of formations encountered	from	to
clay	0	71
sand	71	84
clay	84	126
sand	126	138
clay	138	168
clay w sand streaks	168	208
clay	208	229
rock	229	233
fine sand	233	249
clay	249	270
medium sand	270	291
sand	291	302
clay	302	330
clay w sand streaks	330	351
clay	351	434
fine sand	434	454
medium sand	454	473
good sand	473	520

WELL LOCATION:  
 sec 26 T 7 R 8  
 S W  
8 miles E of OCEAN SPRINGS  
 (distance) (direction) (nearest town)

WELL PURPOSE: Home  
 (home, irrigation, municipal, industrial)

WELL COMPLETION DATA:  
 (1) diameter (inches) 2  
 (2) total depth (feet) 520  
 (3) static water level (feet) 11 below top of ground.  
 (4) casing gal steel, 510'  
 (material) (depth)  
2" If telescope see back.  
 (size)  
 (5) screen 10', 510'  
 (length) (depth to top)  
8 ga, SS on pipe  
 (size) (material)  
 (6) pump 1/2, 2.5  
 (HP) (yield gpm)  
electric  
 (type power)  
 (7) electric log Yes  
 (yes or no)  
 (organization running log)  
 (8) how well bottom plugged Back  
pressure valve


DRILLERS REMARKS:



If well telescopes please sketch and show depths.

SE NE

GROUND LEVEL

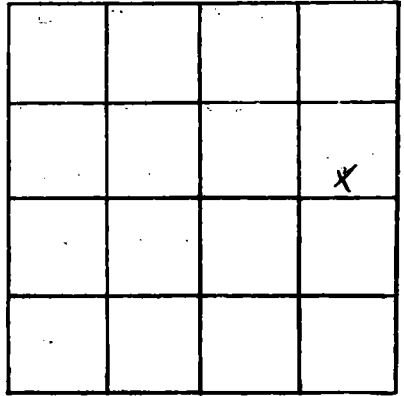

SECTION 26

Please indicate well location X.

ADDITIONAL INFORMATION

If more than one screen, show locations of each on sketch.