

**MISSISSIPPI
BOARD OF WATER COMMISSIONERS**
416 North State Street
Jackson, Mississippi 39201

WATER WELL DRILLERS LOG

Jackson
N 183
5-67
4-5

May 4 1967 M & B Drilling Co. Jackson
date/well completed firm name county well located

LANDOWNER: Hoyd Johnson
Highway 90, Ocean Springs
(mailing address)


WELL LOCATION:
sec 28 T 7 S R 8 E
1 1/2 miles East of Ocean Springs
(distance) (direction) (nearest town)

WELL PURPOSE: Commercial Hotel
(home, irrigation, municipal, industrial)

WELL COMPLETION DATA:

- (1) diameter (inches) 2"
- (2) total depth (feet) 530
- (3) static water level (feet) 17 below top of ground
- (4) casing Galv. Steel 500
(material) (depth)
 If telescope see back.
(size)
- (5) screen 10 FT 500 FT
(length) (depth to top)
#10 steel 2" Stainless Steel
(size) (material)
- (6) pump 1 15
(HP) (yield gpm)
220 volt 1Ø
(type power)
- (7) electric log No
(yes or no)
 (organization running log)
- (8) how well bottom plugged Back Wash
Check

description of formations encountered	from	to
Surface	0	6
White Sand White Clay	6	15
SOFT Grey Clay	15	47
Coarse White Sand	47	62
White Clay	62	65
Black Muck	65	67
Fine Sand	67	85
White Clay	85	93
Gray Sand	93	103
Blue Clay	103	108
Sand, Silt, Clay	108	124
Sand	124	128
Clay	128	135
Fine Sand Silt	135	145
Sand	145	155
Blue Clay	155	255
Fine Sand	255	267
Blue Clay	267	373
Sand	373	380
Blue Clay	380	387
Sand	387	402
Blue Clay	402	460
Fine Sand	460	480
Blue Clay	480	487
Medium Sand	487	530
Blue Clay 500 +		

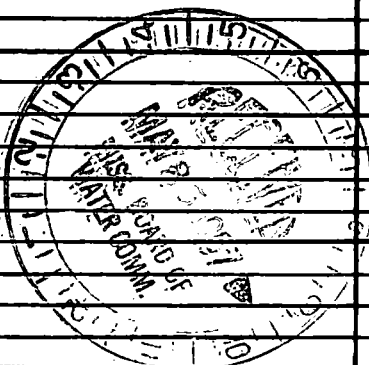

DRILLERS REMARKS:

If well telescopes please sketch and show depths.

GROUND LEVEL

Vertical flow year

max

		X	

SECTION 2P

Please indicate well location X.

ADDITIONAL INFORMATION

If more than one screen, show locations of each on sketch.