


45

JACKSON
N 189
8-67

MISSISSIPPI
BOARD OF WATER COMMISSIONERS
 416 North State Street
 Jackson, Mississippi 39201
WATER WELL DRILLERS LOG

Aug. 24 1967 Coast Water Well Service Jackson
 date well completed firm name county well located


LANDOWNER	description of formations encountered	from	to
May Tapper Route 3 Biloxi Miss (mailing address)			
WELL LOCATION: sec. <u>3</u> T. <u>7</u> N. R. <u>9</u> E. <u>7</u> miles <u>N. West</u> of <u>Osprey</u> (distance) (direction) (nearest town)			
WELL PURPOSE: <u>Home</u> (home, irrigation, municipal, industrial)			
WELL COMPLETION DATA: (1) diameter (inches) <u>2 in.</u> (2) total depth (feet) <u>235</u> (3) static water level (feet) <u>40</u> below top of ground. (4) casing <u>Galv.</u> <u>225</u> (material) (depth) <u>2 in.</u> (size) If telescope see back. (5) screen <u>10 ft.</u> <u>225</u> (length) (depth to top) <u>10 slot Plastic</u> (size) (material) (6) pump <u>1/2</u> <u>8</u> (HP) (yield gpm) <u>Elect.</u> (type power) (7) electric log <u>no</u> (yes or no) <u>N. A.</u> (organization running log) (8) how well bottom plugged <u>Backwash valve</u>			
DRILLERS REMARKS:			

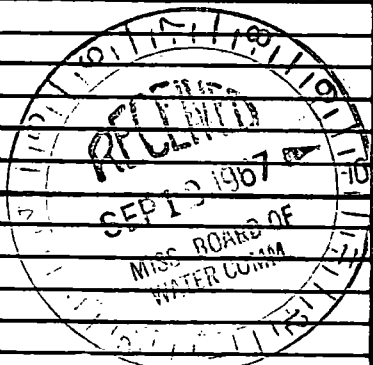

If well telescopes please sketch and show depths.

GROUND LEVEL

NW NW

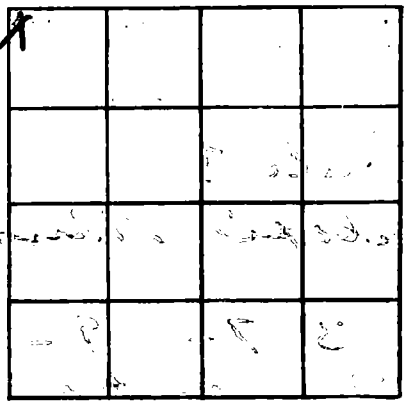

SECTION 3

Please indicate well location X.

ADDITIONAL INFORMATION

Lined area for additional information.

If more than one screen, show locations of each on sketch.