

45

Jackson
N190
9-67

MISSISSIPPI
BOARD OF WATER COMMISSIONERS
416 North State Street
Jackson, Mississippi 39201

WATER WELL DRILLERS LOG

9-18 1967 date well completed
Jetter Well Works firm name
Jackson county well located

LANDOWNER: W. P. Rhoton
Box 534
Biloxi, Miss.
(mailing address)


WELL LOCATION:
sec. 14 T. 8 N. R. 8 E
S W
5 miles SE of Ocean Springs
(distance) (direction) (nearest town)

WELL PURPOSE: home
(home, irrigation, municipal, industrial)

WELL COMPLETION DATA:

- (1) diameter (inches) 4x2
- (2) total depth (feet) 451
- (3) static water level (feet) 2 ^{below} above top of ground.
- (4) casing galv. 441'
(material) (depth)
4" x 2" if telescope see back.
(size)
- (5) screen 10' 441'
(length) (depth to top)
2" stainless steel
(size) (material)
- (6) pump 1 18
(HP) (yield gpm)
elec.
(type power)
- (7) electric log no
(yes or no)
(organization running log)
- (8) how well bottom plugged BP Valued

description of formations encountered	from	to
<u>Sand</u>	<u>0</u>	<u>6</u>
<u>Clay</u>	<u>6</u>	<u>38</u>
<u>sand & shells</u>	<u>38</u>	<u>48</u>
<u>Clay</u>	<u>48</u>	<u>180</u>
<u>sand streaks</u>	<u>180</u>	<u>300</u>
<u>Clay</u>	<u>300</u>	<u>431</u>
<u>Sand</u>	<u>431</u>	<u>451</u>

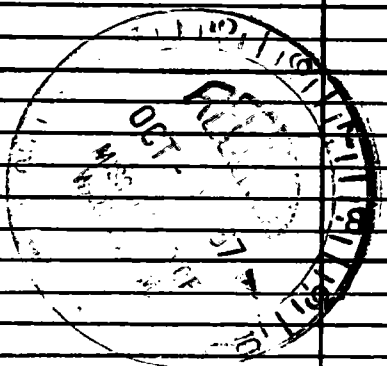

DRILLERS REMARKS:

If well telescopes please sketch and show depths.

GROUND LEVEL

63' of 4"

378' of 2"

2x10 SS Strm.

SW SW

X			

SECTION 14

Please indicate well location X.

ADDITIONAL INFORMATION

If more than one screen, show locations of each on sketch.