

55

Jackson

N 191

9-67

MISSISSIPPI
 BOARD OF WATER COMMISSIONERS
 416 North State Street
 Jackson, Mississippi 39201

WATER WELL DRILLERS LOG

9-28 1967 Switzer Well Co. Jackson
 date well completed firm name county well located

LANDOWNER Lillian Curry

description of formations encountered

from to

W. side Reymoir Rd. S. of
Quave Road.
328 Reymoir - Biloxi
 (mailing address)

clay	0	22
sand	22	32
clay	32	44
mixed	44	64
clay	64	107
mixed	107	130
clay	130	187
sand	187	197
clay	197	255
sand	255	283

WELL LOCATION:

sec. 16 T. 7 S. R. 8 W.
3 miles N of Biloxi
 (distance) (direction) (nearest town)

WELL PURPOSE: Home
 (home, irrigation, municipal, industrial)


WELL COMPLETION DATA:

- (1) diameter (inches) 2
- (2) total depth (feet) 283
- (3) static water level (feet) 14 below top of ground.
- (4) casing gal. steel 223'
 (material) (depth)
2" If telescope see back.
 (size)
- (5) screen 10' 223'
 (length) (depth to top)
8 ga. SS on pipe
 (size) (material)
- (6) pump 1/2 8.5
 (HP) (yield gpm)
electric
 (type power)
- (7) electric log No
 (yes or no)

(organization running log)

(8) how well bottom plugged Back
pressure valve


DRILLERS REMARKS:

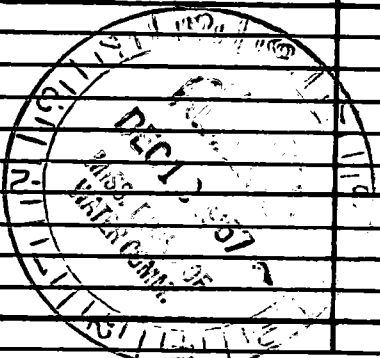

If well telescopes please sketch and show depths.

NW SW

GROUND LEVEL

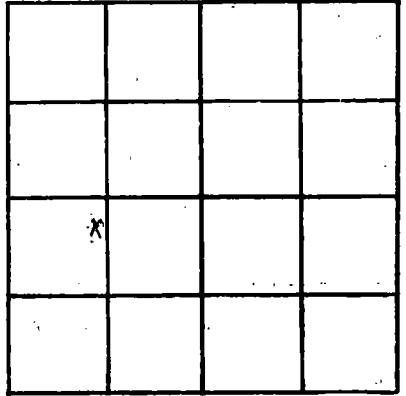

SECTION 16

Please indicate well location X.

ADDITIONAL INFORMATION

If more than one screen, show locations of each on sketch.