

Jackson
N 193
11-67


MISSISSIPPI  
BOARD OF WATER COMMISSIONERS  
416 North State Street  
Jackson, Mississippi 39201

WATER WELL DRILLERS LOG

Nov. 15 1967 M & B Drilling Co. Jackson  
date well completed firm name county well located


LANDOWNER:	description of formations encountered	from	to
Isi Williams	Old well	0	210
R.R. Ocean Springs, Miss. (mailing address)	Blue Clay	210	345
	Coarse Sand	345	355
WELL LOCATION: sec. 12 T. 2 S. R. 9 E. W. 2 miles N of Ocean Springs (distance) (direction) (nearest town)	10 FT of sand is usually too thin for good well. This well is excellent. Reason for trying in 10 FT of sand is that we have put in several wells in area at this depth & 30% 40 FT of sand in most places.		
WELL PURPOSE: Home (home, irrigation, municipal, industrial)			
WELL COMPLETION DATA:			
(1) diameter (inches) 2"			
(2) total depth (feet) 357			
(3) static water level (feet) 18 below top of ground.			
(4) casing Calumet Steel 347 (material) (depth)			
2" (size) If telescope see back.			
(5) screen 10 FT, 347 (length) (depth to top)			
2" size, Brass (material)			
(6) pump 1 (HP) 15 (yield gpm)			
110 V 1φ (type power)			
(7) electric log No (yes or no)			
(organization running log)			
(8) how well bottom plugged 2" Back Wash Check			
DRILLERS REMARKS: 210 FT deep Puffed old well, 2 years old, producing 3 gpm. Driller would not return, deepened & same pump on new well produced 15 gpm.			

John E. Beaton

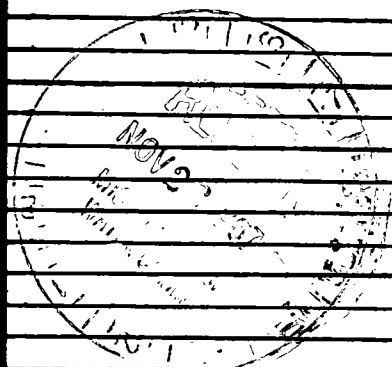

If well telescopes please sketch and show depths.

GROUND LEVEL

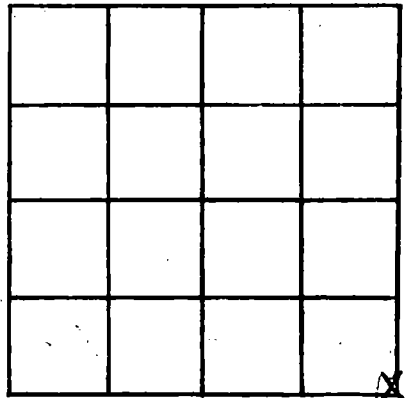

SECTION 12

Please indicate well location X.

**ADDITIONAL INFORMATION**

A series of horizontal lines for entering additional information.

If more than one screen, show locations of each on sketch.