

1/4 mi. E.
Jackson
 N 196
 12-67

MISSISSIPPI
 BOARD OF WATER COMMISSIONERS
 416 North State Street
 Jackson, Mississippi 39201

WATER WELL DRILLERS LOG

12-12 19 67 date well completed Switzer Hell C. firm name Jackson county well located

LANDOWNER: D. Galonovich

Highway 90
Ocean Springs, Miss
 (mailing address)

WELL LOCATION:
 sec. 27 T. 7 S. R. 8 W.
1 miles E of OCEAN SPRINGS
 (distance) (direction) (nearest town)

WELL PURPOSE: Home
 (home, irrigation, municipal, industrial)


WELL COMPLETION DATA:

- (1) diameter (inches) 3 x 2
- (2) total depth (feet) 506
- (3) static water level (feet) 12 below top of ground.
- (4) casing gal. steel (material) 486' (depth)
3 x 2 (size) if telescope see back.
- (5) screen 20' (length) 486' (depth to top)
8ga (size) SS on pipe (material)
- (6) pump not installed (HP) (yield gpm)
 (type power)
- (7) electric log No (yes or no)
 (organization running log)

(8) how well bottom plugged Back pressure valve

DRILLERS REMARKS:


description of formations encountered	from	to
clay	0	4
sand	4	36
clay	36	87
sand	87	90
clay	90	106
sand	106	112
mixed	112	144
clay	144	154
sand	154	166
clay	166	176
mixed	176	219
clay	219	438
fair sand	438	483
good sand	483	526

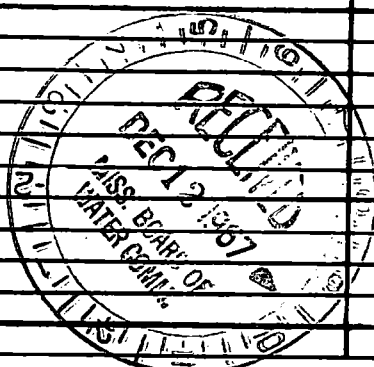

If well telescopes please sketch and show depths.

GROUND LEVEL

NE NW

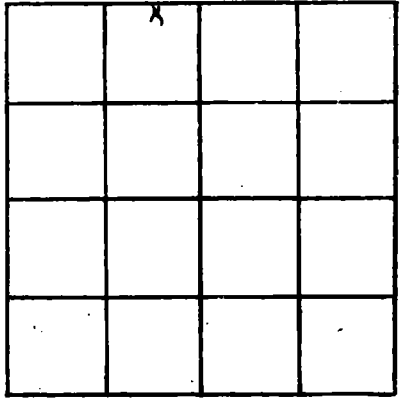

SECTION 27

Please indicate well location X.

ADDITIONAL INFORMATION

If more than one screen, show locations of each on sketch.