

Sutton Rd

45

Jackson

N198

1-68

MISSISSIPPI
BOARD OF WATER COMMISSIONERS
416 North State Street
Jackson, Mississippi 39201

WATER WELL DRILLERS LOG

January 1968
date well completed

L.H. Garland
firm name

Jackson
county well located

LANDOWNER:

Herman Boyd

description of formations
encountered

from to

Rt 3 Box 127A Ocean Springs
(mailing address)

Medium Sand
gray

418 432

WELL LOCATION:

sec 28 T 7 N R 8 E
S W

miles of
(distance) (direction) (nearest town)

WELL PURPOSE: home
(home, irrigation, municipal, industrial)

WELL COMPLETION DATA:

- (1) diameter (inches) 2"
- (2) total depth (feet) 432'
- (3) static water level (feet) 5 ^{below} above top of ground.
- (4) casing Black Iron 422' (material), (depth)
2" (size) if telescope see back.
- (5) screen 10' 422' (length), (depth to top)
.008 Brass (size), (material)
- (6) pump 1/2 (HP) - (yield gpm)
Elec. (type power)
- (7) electric log NO (yes or no)

(organization running log)

(8) how well bottom plugged BWV

DRILLERS REMARKS:

No pumping Test


If well telescopes please sketch and show depths.

GROUND LEVEL

100'
4"

500'
2"

NE SE

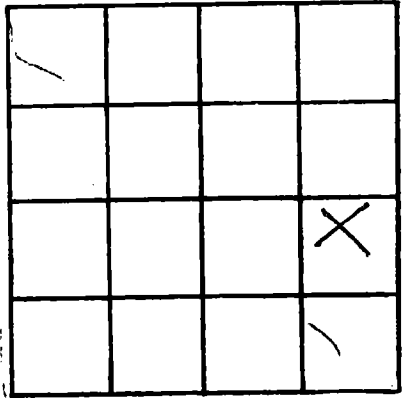

SECTION 28

Please indicate well location X.

ADDITIONAL INFORMATION

If more than one screen, show locations of each on sketch.