

begin St. Martin School
behind washette.

Jackson
N 199
1-68

MISSISSIPPI
BOARD OF WATER COMMISSIONERS
416 North State Street
Jackson, Mississippi 39201

WATER WELL DRILLERS LOG

1-25 1968 Switzer Well Co. Jackson
date well completed firm name county well located

LANDOWNER: C. P. Turk
Old Hwy 90, Biloxi
Mississippi
(mailing address)

WELL LOCATION:
sec. 16 T. 7 S. R. 9 W.
4 miles N of Biloxi
(distance) (direction) (nearest town)

WELL PURPOSE:
(home, irrigation, municipal, industrial)


WELL COMPLETION DATA:

- (1) diameter (inches) top 93' of 4" 4 x 3
- (2) total depth (feet) 858
- (3) static water level (feet) 9'6" below top of ground.
- (4) casing gal. steel 828'
(material) (depth)
4 x 3 If telescope see back.
(size)
- (5) screen 30' 828'
(length) (depth to top)
10 ga. ss on pipe
(size) (material)
- (6) pump 1 1/2 25
(HP) (yield gpm)
electric
(type power)
- (7) electric log No
(yes or no)

(organization running log)
(8) how well bottom plugged Back pressure valve

DRILLERS REMARKS:


description of formations encountered	from	to
clay	0	10
sand	10	44
clay	44	153
mixed	153	163
clay	163	242
fine sand	242	264
mixed	264	286
clay	286	401
sand	401	419
clay	419	485
sand	485	490
clay	490	507
fine sand	507	527
mixed	527	549
clay	549	593
sand	593	625
clay	625	733
fine sand	733	748
sand	748	858

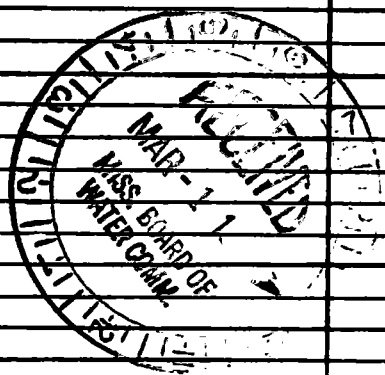

If well telescopes please sketch and show depths.

SW SW

GROUND LEVEL

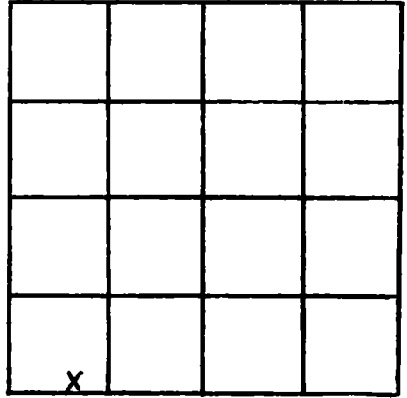

SECTION 16

Please indicate well location X.

ADDITIONAL INFORMATION

If more than one screen, show locations of each on sketch.