

JACKSON

N 200

WATER WELL DRILLERS LOG



8-26-60

Date: Aug 26, 1960, Driller: C. T. Switzer Well Co. County: Jackson

55

(Name)

(1) Owner of Land: M. D. Goff, Jr.
on Davidson Road - 1/2 mile East of
Intersection of Holcomb & Davidson Rds.
 (Address)

(2) Location: 1/4, SW 1/4, Sec. 29 T25R 8E
50 yards miles S of Ocean Springs
 (distance) (direction) (Nearest Town)

(3) Topography: (Hilly) (Flat) (Level)

(4) Purpose of Well: Domestic
 (Domestic Irrigation, Municipal, Industrial, Other)

| Description & Color of Materials Sand, Clay, Red Clay, Shell, etc. | Thick- ness Feet | Depth Feet |
|---|------------------------|---------------|
| <u>Surface sand</u> | <u>0</u> | <u>10</u> |
| <u>Clay</u> | <u>10</u> | <u>19</u> |
| <u>sand</u> | <u>19</u> | <u>61</u> |
| <u>Clay</u> | <u>61</u> | <u>83</u> |
| <u>stratified</u> | <u>83</u> | <u>123</u> |
| <u>Coarse sand</u> | <u>123</u> | <u>152</u> |
| <u>Clay</u> | <u>152</u> | <u>156</u> |
| <u>stratified</u> | <u>156</u> | <u>180</u> |
| <u>Clay</u> | <u>180</u> | <u>282</u> |
| <u>sand</u> | <u>282</u> | <u>286</u> |
| <u>Clay</u> | <u>286</u> | <u>310</u> |
| <u>Extra good sand</u> | <u>310</u> | <u>344</u> |

Information upon completion of well:

(1) Diameter 2 inches.

(2) Total Depth 344 feet.

(3) Water Level 10'-5" feet below top of ground.

(4) Cased to 344', Size 2"


(5) Screen: Size 2", Length 15' or 9 ft

(6) Were any formations sealed against pollution?
 yes, no.

If YES depth of formation 10 feet

Why Health dept. requirements

Drillers Remarks:

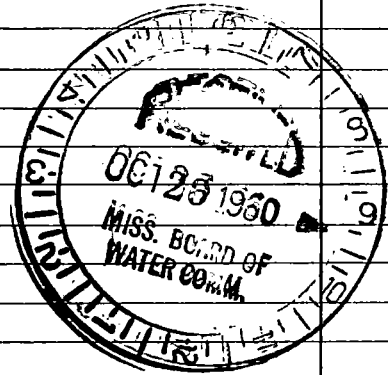

(Use Back Side)

Well No.

