

200 miles or less from Jackson, Miss.  
on State or Federal road

JACKSON  
N 204  
4-68

MISSISSIPPI  
BOARD OF WATER COMMISSIONERS  
416 North State Street  
Jackson, Mississippi 39201  
WATER WELL DRILLERS LOG

4-9 1968 Switzer Well Co. Jackson  
date well completed firm name county well located

LANDOWNER: John Catalanatto  
Route 3, Box 404  
Ocean Springs, Miss.  
(mailing address)

description of formations encountered	from	to
sand	0	32
clay	32	43
mixed	43	84
fine sand	84	119
clay	119	125
mixed	125	167
clay	167	188
mixed	188	208
clay	208	227
mixed	227	248
clay	248	270
mixed	270	291
sand	291	299
clay	299	309
mixed	309	329
clay	329	340
sand	340	362

WELL LOCATION:  
sec. 12 T. 7 S. R. 9 W.  
3 miles NW of OCEAN SPRING  
(distance) (direction) (nearest town)

WELL PURPOSE: Home  
(home, irrigation, municipal, industrial)


WELL COMPLETION DATA:  
(1) diameter (inches) 2  
(2) total depth (feet) 362  
(3) static water level (feet) 35 below top of ground.  
(4) casing gal. steel, 352' (material) (depth)  
2" if telescope see back. (size)  
(5) screen 10', 342' (length) (depth to top)  
80a, SS on pipe (size) (material)  
(6) pump 1/2, 8.5 (HP) (yield gpm)  
electric (type power)  
(7) electric log No (yes or no)  
(organization running log)  
(8) how well bottom plugged Back pressure valve

DRILLERS REMARKS:

PAID

If well telescopes please sketch and show depths.

GROUND LEVEL

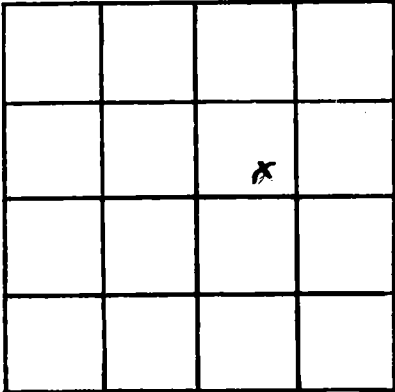

SECTION 12

Please indicate well location X.

ADDITIONAL INFORMATION

Lined area for additional information.

If more than one screen, show locations of each on sketch.