

JACKSON

N 205

3-68

MISSISSIPPI  
 BOARD OF WATER COMMISSIONERS  
 416 North State Street  
 Jackson, Mississippi 39201

WATER WELL DRILLERS LOG

march 30 1968 L. L. Garland Water Well Jackson  
 date well completed firm name county well located

LANDOWNER: Donald Rushing

description of formations encountered

from to

1504 Government St.

Ocean Springs, Miss.  
(mailing address)

WELL LOCATION:

sec. 12 T. 7 N. R. 9 E.

2 1/2 miles n.w. of sd  
(distance) (direction) (nearest town)

WELL PURPOSE: home  
(home, irrigation, municipal, industrial)

WELL COMPLETION DATA:

- (1) diameter (inches) 2 x 4
- (2) total depth (feet) 756
- (3) static water level (feet) 17 below <sup>below</sup> above top of ground.

(4) casing \_\_\_\_\_ (material) \_\_\_\_\_ (depth) \_\_\_\_\_  
\_\_\_\_\_ (size) if telescope see back.

(5) screen 10 ft. \_\_\_\_\_ (length) \_\_\_\_\_ (depth to top)  
2" \_\_\_\_\_ (size) \_\_\_\_\_ (material)


(6) pump 1/2 Submersible \_\_\_\_\_ (HP) \_\_\_\_\_ (yield gpm)  
electric \_\_\_\_\_ (type power)

(7) electric log no \_\_\_\_\_ (yes or no)  
\_\_\_\_\_ (organization running log)

(8) how well bottom plugged w. valve


DRILLERS REMARKS:

Well set in 34 ft of sand

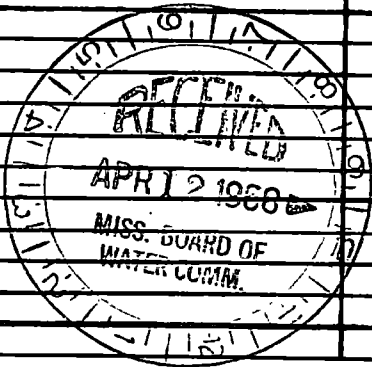

If well telescopes please sketch and show depths.

GROUND LEVEL

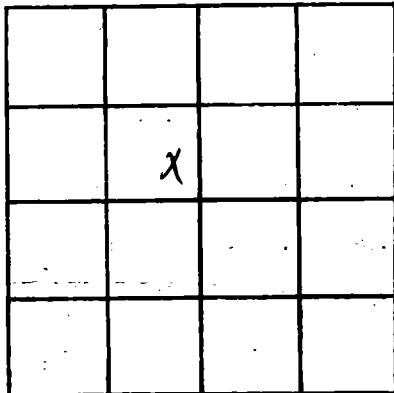

SECTION 12

Please indicate well location X.

ADDITIONAL INFORMATION

If more than one screen, show locations of each on sketch.