


JACKSON
 N 206
 4-68

MISSISSIPPI
 BOARD OF WATER COMMISSIONERS
 416 North State Street
 Jackson, Mississippi 39201

WATER WELL DRILLERS LOG

April 4 1968 L.L. Garland water wells Jackson
 date well completed firm name county well located

LANDOWNER: <u>Lattimer Community House</u>	description of formations encountered	from	to
<u>Lattimer P.O. Miss</u> (mailing address)			
WELL LOCATION: sec. <u>12</u> T <u>7</u> N R <u>9</u> E 3 miles <u>n.w.</u> of <u>L.S.</u> (distance) (direction) (nearest town)			
WELL PURPOSE: (home, irrigation, municipal, industrial)			
WELL COMPLETION DATA: (1) diameter (inches) <u>2"</u> (2) total depth (feet) <u>279</u> (3) static water level (feet) <u>18</u> ^{below} _{above} top of ground. (4) casing _____, _____, _____ (material) (depth) _____ if telescope see back. (size) (5) screen <u>10ft</u> , _____ (length) (depth to top) <u>2"</u> , <u>brass</u> (size) (material) (6) pump <u>1/2 hp well pump</u> (HP) (yield-gpm) <u>electric</u> (type power) (7) electric log _____ (yes or no) _____ (organization running log) (8) how well bottom plugged <u>w. valve</u>			
DRILLERS REMARKS: <u>well set in 17ft sand</u>			

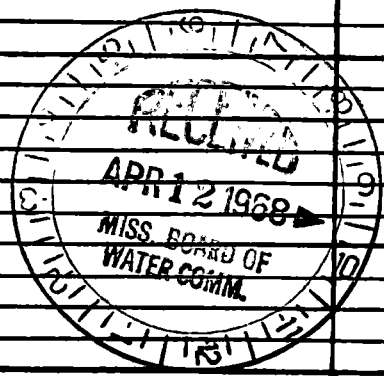

If well telescopes please sketch and show depths.

GROUND LEVEL

	λ		

SECTION 12

Please indicate well location X.

ADDITIONAL INFORMATION

If more than one screen, show locations of each on sketch.