

JACKSON  
 N 207  
 4-68

MISSISSIPPI  
 BOARD OF WATER COMMISSIONERS  
 416 North State Street  
 Jackson, Mississippi 39201

WATER WELL DRILLERS LOG

April 2 1968 L. L. Garland Water Wells Jackson  
 date well completed firm name county well located

LANDOWNER: Leuter L. Cook

description of formations encountered from to

Rt. 1 Box 375

Olean Springs, Miss.  
 (mailing address)

WELL LOCATION:

sec. 2 T. 7 N R. 9 E  
 (S) (W)  
 3 miles west of Olean  
 (distance) (direction) (nearest town)

WELL PURPOSE: Home  
 (home, irrigation, municipal, industrial)

WELL COMPLETION DATA:

(1) diameter (inches) 2"

(2) total depth (feet) 399

(3) static water level (feet) below above top of ground.

(4) casing (material), (depth), (size) if telescope see back.


(5) screen 10 ft, (length) (depth to top) 2", (size) brass (material)

(6) pump 1/2 hp (HP) (yield gpm) electric (type power)

(7) electric log no (yes or no) (organization running log)


(8) how well bottom plugged w. shale

DRILLERS REMARKS:  
well set in 32 ft of sand

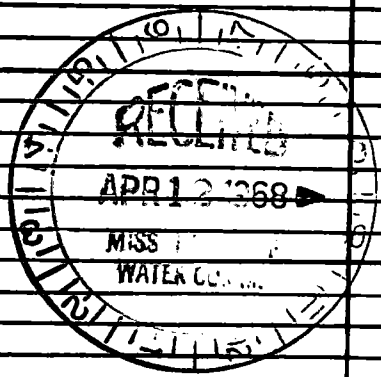

If well telescopes please sketch and show depths.

GROUND LEVEL

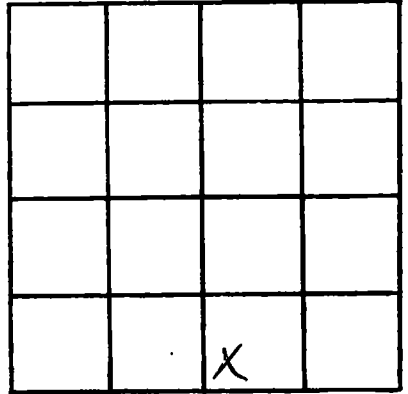

SECTION 2

Please indicate well location X.

ADDITIONAL INFORMATION

If more than one screen, show locations of each on sketch.