

JACKSON
 N 208
 4-68

MISSISSIPPI
 BOARD OF WATER COMMISSIONERS
 416 North State Street
 Jackson, Mississippi 39201

WATER WELL DRILLERS LOG

April 8 1968 L.L. Garland Water Wells Jackson
 date well completed firm name county well located

LANDOWNER: Leonard Vergunst
 Rt. 3

description of formations encountered from to

Ocean Springs, Miss
 (mailing address)

WELL LOCATION:

sec. 25 T 7 N R 8 E
 (S) (W)
 3 1/2 miles east of O.S.
 (distance) (direction) (nearest town)

WELL PURPOSE: Home
 (home, irrigation, municipal, industrial)

WELL COMPLETION DATA:


- (1) diameter (inches) 2
- (2) total depth (feet) 472
- (3) static water level (feet) 7 ^{below} top of ground.
- (4) casing (material) (depth) (size) if telescope see back.
- (5) screen 10 ft (length) (depth to top) 2" (size) brass (material)
- (6) pump 1/2 (HP) (yield gpm) electric (type power)
- (7) electric log (yes or no) (organization running log)
- (8) how well bottom plugged w. valve

JUN 4 1968
 MISS. BOARD OF
 WATER COMMISSIONERS

DRILLERS REMARKS: 31 ft. of water bearing sand

If well telescopes please sketch and show depths.

GROUND LEVEL

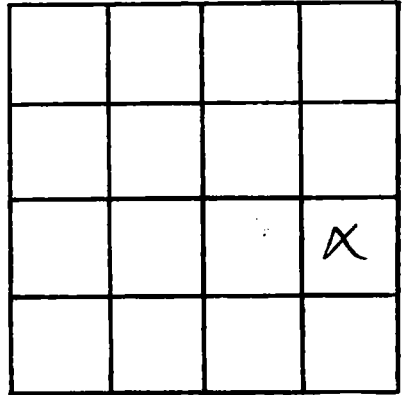

SECTION 25

Please indicate well location X.

ADDITIONAL INFORMATION

If more than one screen, show locations of each on sketch.