

JACKSON
N 210
5-68

MISSISSIPPI
BOARD OF WATER COMMISSIONERS
416 North State Street
Jackson, Mississippi 39201

WATER WELL DRILLERS LOG

may 1 1968 L. L. Garland Waterwells Jackson
date well completed firm name county well located

LANDOWNER: J. M. Waite

Rt. 1 Box 312

Ocean Springs, Miss
(mailing address)

description of formations
encountered

from to

WELL LOCATION:

sec. 1 T. 7 N R. 9 E
2 miles west of D. S.
(distance) (direction) (nearest town)

WELL PURPOSE: home
(home, irrigation, municipal, industrial)

WELL COMPLETION DATA:

- (1) diameter (inches) 2
- (2) total depth (feet) 354
- (3) static water level (feet) 27 below
top of ground. above
- (4) casing (material) (depth)
(size) If telescope see back.
- (5) screen 10 344
(length) (depth to top)
2 brass
(size) (material)
- (6) pump (HP) (yield gpm)
(type power)

(7) electric log (yes or no)
(organization running log)

(8) how well bottom plugged W. Valve

JUN - 4 1968


MISS. BOARD OF
WATER COMM.

DRILLERS REMARKS: 38 ft

water bearing sand

If well telescopes please sketch and show depths.

GROUND LEVEL

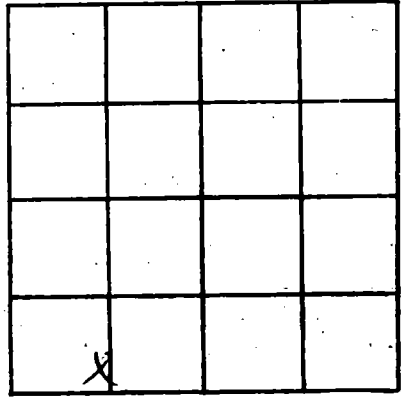

SECTION 1

Please indicate well location X.

ADDITIONAL INFORMATION

If more than one screen, show locations of each on sketch.