

CODED

MISSISSIPPI
BOARD OF WATER COMMISSIONERS
416 North State Street
Jackson, Mississippi 39201

WATER WELL DRILLERS LOG

Jackson
N 211
568

5-29 1968 M & B Drilling Co. Jackson
date well completed firm name county well located

LANDOWNER:
Milton Johnson
Biloxi, Miss.
(mailing address)

WELL LOCATION:
sec. 15 T 7 S R 9 E W
of DeTherrell
(distance) (direction) (nearest town)

WELL PURPOSE: Community - Home
(home, irrigation, municipal, industrial)

WELL COMPLETION DATA:

- (1) diameter (inches) 4 X 2
- (2) total depth (feet) 300
- (3) static water level (feet) 15 below top of ground
- (4) casing PVC 260 - 280-300 Tail Pipe
(material) (depth) 4 X 2 (size) if telescope see back.
- (5) screen 20 (length) 260 (depth to top)
24 (size) PVC Sand Pac (material)
- (6) pump 1 (HP) 20 (yield gpm)
220 (type power) 5 1/2 horsepower
- (7) electric log No (yes or no)
- (8) how well bottom plugged 2" PVC Cap

description of formations encountered	from	to
Surface Clay	0	18
Sand & Clay Breaker	14	38
Dark Grey Clay	38	48
Sandy Wood Swamp	48	60
Blue Clay	60	68
Sand	68	80
Grey Clay	80	98
Blue Clay	98	100
Sand & Clay Breaker	110	135
Blue Clay	135	232
Sand	232	239
Blue Clay	239	246
Sand	246	252
Blue Clay	252	252
Grey Sand	252	283
Clay - Blue	283	286
Sand	286	290
Blue Clay	290	300+

Stop - 54-57

JUN 5 1968
MISS. BOARD OF WATER COMMISSIONERS

DRILLERS REMARKS:

If well telescopes please sketch and show depths.

GROUND LEVEL

100 FT 4"
PVC


2" PVC

260
20 FT 2"
PVC Sand Pack
Screen

280

2" PVC

300
2" PVC Cap

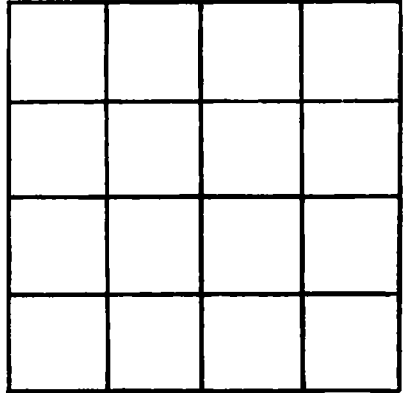

SECTION _____

Please indicate well location X.

ADDITIONAL INFORMATION

Lined area for additional information.

If more than one screen, show locations of each on sketch.