

CODED

MISSISSIPPI
BOARD OF WATER COMMISSIONERS
416 North State Street
Jackson, Mississippi 39201

WATER WELL DRILLERS LOG

Jackson
N214
6-68

Jackson
~~39201~~
county well located

6-18 1968 Switzer Well Co.
date well completed firm name

LANDOWNER: Mr. H. Cagle
Route 3 Box 477A
Biloxi, Miss. 39532
(mailing address)

description of formations encountered	from	to
clay	0	14
sand	14	36
clay	36	65
mixed	65	86
clay	86	105
fine sand	105	156

WELL LOCATION:
sec. 15 T 7 N R 9 W
S W
5 miles NE of Biloxi
(distance) (direction) (nearest town)

WELL PURPOSE: Home
(home, irrigation, municipal, industrial)

WELL COMPLETION DATA:

- (1) diameter (inches) 2
- (2) total depth (feet) 150
- (3) static water level (feet) 6 1/2 below top of ground.
- (4) casing gal steel, 140'
(material) (depth)
2" If telescope see back.
(size)
- (5) screen 10', 140'
(length) (depth to top)
8 ga, SS on pipe
(size) (material)
- (6) pump 1/2 8.5
(HP) (yield gpm)
electric
(type power)
- (7) electric log Yn
(yes or no)

(organization running log)


(8) how well bottom plugged Back pressure valve

DRILLERS REMARKS:

8 1968
MISS. REG. 67
WATER BOARD

If well telescopes please sketch and show depths.

GROUND LEVEL

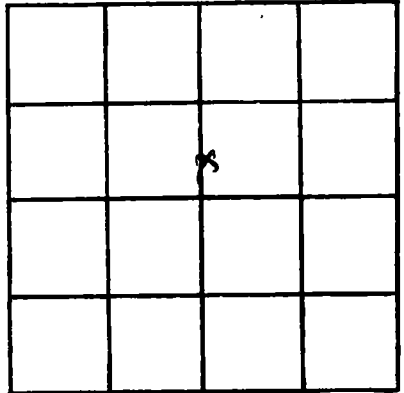

SECTION 10

Please indicate well location X.

ADDITIONAL INFORMATION

Lined area for additional information.

If more than one screen, show locations of each on sketch.