

one mile East off  
Gorefield on Cook Rd.

**CODED**

Jackson  
N 216  
10-22-68

MISSISSIPPI  
BOARD OF WATER COMMISSIONERS  
416 North State Street  
Jackson, Mississippi 39201

WATER WELL DRILLERS LOG

10-22-1968 date well completed  
Switzer Well Co firm name  
Jackson county well located

LANDOWNER: Bernard Skartwick  
Route 3 Box 314-A  
Biloxi Miss  
(mailing address)

description of formations encountered	from	to
mixed	0	64
fine sand	64	85
sand	85	93
clay	93	146
mixed	146	186
clay	186	204
sand	204	206
fine sand	206	227
clay	227	230
sand	230	258
good clay	258	270
clay	270	291
mixed	291	349
clay	349	365
sand	365	369
fine sand	369	390
good sand	390	468

WELL LOCATION:  
sec. 3 T 7 N R. 9 W  
S W  
4 miles NE of BILOXI  
(distance) (direction) (nearest town)

WELL PURPOSE: Home  
(home, irrigation, municipal, industrial)

WELL COMPLETION DATA:

(1) diameter (inches) 2

(2) total depth (feet) 468

(3) static water level (feet) 21 below above top of ground.

(4) casing gal steel 453'  
(material) (depth)  
2" If telescope see back.  
(size)

(5) screen 15' 453'  
(length) (depth to top)  
8ga. ss on pipe  
(size) (material)

(6) pump not installed  
(HP) (yield gpm)  
  
(type power)

(7) electric log No  
(yes or no)  
  
(organization running log)

(8) how well bottom plugged Back  
pressure valve

**CODED**


NOV 12 1968

MISS. BD. OF  
WATER COMM.

DRILLERS REMARKS:

If well telescopes please sketch and show depths.

GROUND LEVEL

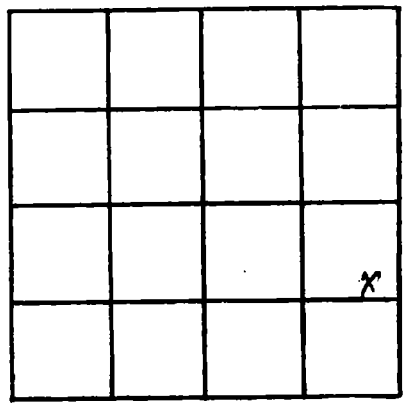

SECTION 3

Please indicate well location X.

ADDITIONAL INFORMATION

A series of horizontal lines for writing additional information.

If more than one screen, show locations of each on sketch.