

Directly Behind  
Gulf Hills Hotel

Jackson  
N 217  
6-28-68

MISSISSIPPI  
BOARD OF WATER COMMISSIONERS  
416 North State Street  
Jackson, Mississippi 39201

CODED

WATER WELL DRILLERS LOG

6-28 1968 Switzer Shell Co. Jackson  
date well completed firm name county well located

LANDOWNER: Coast Waterworks

description of formations encountered

from to

120 Pass Road

mixed 0 22

Biloxi Miss

clay 22 60

(mailing address)

sand 60 65

WELL LOCATION:

fair sand 65 107

sec. 13 T 7 N R 9 E  
S W  
2 miles N of OCEAN SPRINGS  
(distance) (direction) (nearest town)

clay 107 128

mixed 128 149

sand 149 158

fine clay 158 168

fine sand 168 189

WELL PURPOSE: subdivision  
(home, irrigation, municipal, industrial)

fair sand 189 210

sand 210 223

WELL COMPLETION DATA:

good clay 223 229

(1) diameter (inches) 8 x 6

mixed 229 290

(2) total depth (feet) 525

clay 290 309

(3) static water level (feet) 8' 10" below top of ground.

mixed 309 322

clay 322 388

(4) casing gal. steel, 4 1/2" (material) (depth)

sand 388 393

mixed 393 415

clay 415 426

8 x 6 (size) If telescope see back.

fine sand 426 478

good sand 478 525

(5) screen 50' (length), 4 1/2" (depth to top)

800 (size), SS on pipe (material)

(6) pump 20 (HP), 250 (yield gpm)

electric (type power)

(7) electric log No (yes or no)

(organization running log)

(8) how well bottom plugged Back pressure valve


NOV 12 1968

DRILLERS REMARKS:

MISS. BD. OF  
WATER COMM.

If well telescopes please sketch and show depths.

GROUND LEVEL

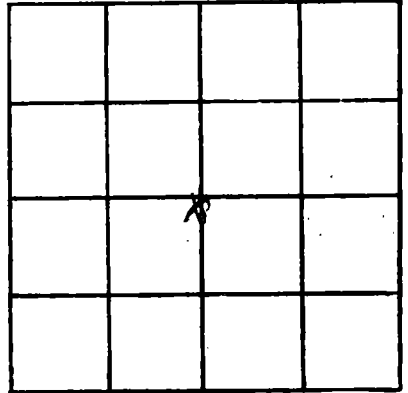

SECTION 13

Please indicate well location X.

ADDITIONAL INFORMATION

If more than one screen, show locations of each on sketch.