

Jackson  
 N 219  
 7-17-68

MISSISSIPPI  
 BOARD OF WATER COMMISSIONERS  
 416 North State Street  
 Jackson, Mississippi 39201

CODED

WATER WELL DRILLERS LOG

7-17 1968 Coast Water Well Serv. Jackson  
 date well completed firm name county well located

LANDOWNER: Bertha Skinner

117 Ruyssir Road  
A. Biloxi Miss.  
 (mailing address)

description of formations encountered	from	to
	<u>yellow &amp; blue clay</u>	<u>0</u>
<u>fine sand</u>	<u>21</u>	<u>37</u>
<u>blue clay</u>	<u>37</u>	<u>42</u>
<u>red sand</u>	<u>42</u>	<u>72</u>
<u>blue clay &amp; sand</u>	<u>72</u>	<u>262</u>
<u>fine sand</u>	<u>262</u>	<u>283</u>
<u>blue clay</u>	<u>283</u>	<u>329</u>
<u>fine sand</u>	<u>329</u>	<u>357</u>

WELL LOCATION:  
 sec. 15 T. 7 N. R. 9 E.  
 S. W.  
2 3/4 miles N.E. of Biloxi  
 (distance) (direction) (nearest town)

WELL PURPOSE: Home  
 (home, irrigation, municipal, industrial)

- WELL COMPLETION DATA:
- (1) diameter (inches) 2"
- (2) total depth (feet) 357
- (3) static water level (feet) 24 below  
 top of ground.
- (4) casing 2" galv., 247'  
 (material) (depth)  
2"  
 (size) If telescope see back.
- (5) screen 10', 247'  
 (length) (depth to top)  
2", Wrapped Staples  
 (size) (material)
- (6) pump 1 10  
 (HP) (yield gpm)  
Elec.  
 (type power)
- (7) electric log NO  
 (yes or no)
- (organization running log)

(8) how well bottom plugged Back  
Wash Valve


DRILLERS REMARKS:

DEC 30 1968

MISS. BD. OF  
 WATER COMM.

If well telescopes please sketch and show depths.

GROUND LEVEL

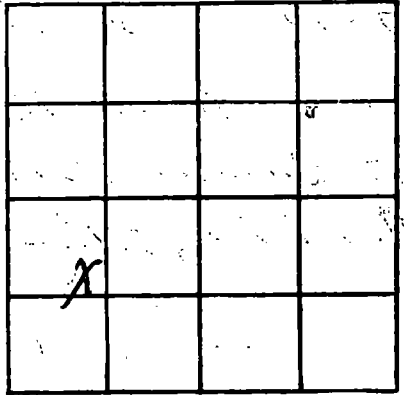

SECTION 15

Please indicate well location X.

ADDITIONAL INFORMATION

If more than one screen, show locations of each on sketch.