

3/4 mi. off Goreville on  
Cook Road

MISSISSIPPI  
BOARD OF WATER COMMISSIONERS  
416 North State Street  
Jackson, Mississippi 39201

CODED

WATER WELL DRILLERS LOG

Jackson  
N223  
10-19-68

10-19 1968 date well completed  
Switzer Well Co. firm name  
Jackson county well located

LANDOWNER: Spiford Watkins

description of formations encountered

from to

Cook Road - Amerilla Oak  
Biloxi, Miss  
(mailing address)

mixed	0	22
clay	22	64
good sand	64	85
clay	85	106
mixed	106	127
fine sand	127	146
mixed	146	203
clay	203	224
mixed	224	245
clay	245	267
mixed	267	328
clay	328	349
mixed	349	367
fine sand	367	386
good sand	386	448

WELL LOCATION:

sec. 3 T. 7 S. R. 9 W.  
4 miles NE of Biloxi  
(distance) (direction) (nearest town)

WELL PURPOSE: Home  
(home, irrigation, municipal, industrial)

WELL COMPLETION DATA:

- (1) diameter (inches) 2
- (2) total depth (feet) 448
- (3) static water level (feet) 21' 2" below above top of ground.
- (4) casing gal. steel 4 1/2" (material) (depth)  
2" If telescope see back. (size)
- (5) screen 10' (length) 438' (depth to top)  
8 ga. (size) SS on pipe (material)
- (6) pump 1/2 (HP) 3.5 GPM (yield gpm)  
electric (type power)
- (7) electric log No (yes or no)

CODED

(organization running log)

(8) how well bottom plugged Back pressure valve


DRILLERS REMARKS:

NOV 12 1968

MISS. BD. OF  
WATER COMM.

If well telescopes please sketch and show depths.

GROUND LEVEL

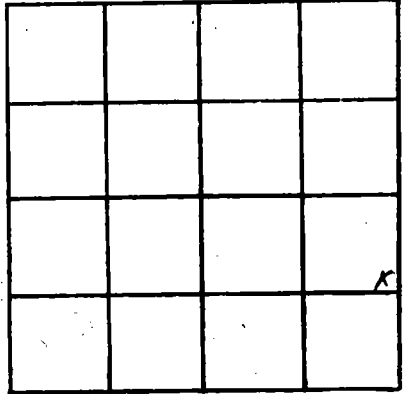

SECTION 3

Please indicate well location X.

ADDITIONAL INFORMATION

If more than one screen, show locations of each on sketch.