


Jackson  
 N 226  
 3-69

MISSISSIPPI  
 BOARD OF WATER COMMISSIONERS  
 416 North State Street  
 Jackson, Mississippi 39201

CODED

WATER WELL DRILLERS LOG

March 1 1969 L. L. Garland W. Well Jackson  
 date well completed firm name county well located

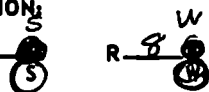LANDOWNER: <u>Thomas J. Hoff</u>	description of formations encountered	from	to
<u>Pt. 3 Box 403</u>			
<u>N. Biloxi, Miss</u> (mailing address)			
WELL LOCATION: sec. <u>B</u> T- <u>7</u>  R- <u>8</u> <u>2</u> miles <u>north</u> of <u>P.S.</u> (distance) (direction) (nearest town)			
WELL PURPOSE: <u>home</u> (home, irrigation, municipal, industrial)			
WELL COMPLETION DATA: (1) diameter (inches) <u>2</u> (2) total depth (feet) <u>1355</u> (3) static water level (feet) <u>39</u> <u>below</u> above top of ground. (4) casing <u>steel</u> , <u>345</u> (material) (depth) <u>2"</u> (size) If telescope see back. <u>10'</u> (5) screen <u>345</u> (length) (depth to top) <u>008</u> , <u>brass</u> (size) (material) (6) pump <u>1/2</u> <u>725</u> (HP) (yield <del>gpm</del> ) <u>electric</u> <u>hr</u> (type power) (7) electric log <u>no</u> (yes or no) (organization running log) (8) how well bottom plugged <u>L. W. Vabe</u>			

CODED


DRILLERS REMARKS:  
18 ft. water bearing sand

MAR 10 1969

MISS. Bd. of WATER COMMISSIONERS

If well telescopes please sketch and show depths.

GROUND LEVEL

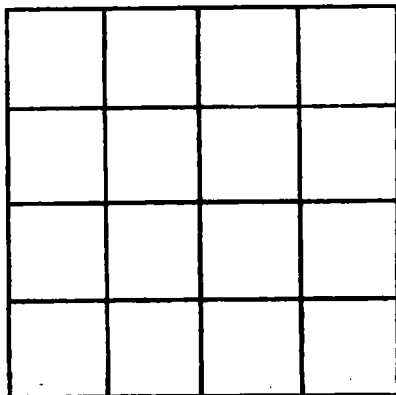

SECTION \_\_\_\_\_

Please indicate well location X.

ADDITIONAL INFORMATION

If more than one screen, show locations of each on sketch.