

Jackson
 N 228
 7-15-66

MISSISSIPPI
 BOARD OF WATER COMMISSIONERS
 416 North State Street
 Jackson, Mississippi 39201

CODED

WATER WELL DRILLERS LOG

July 15 1966 Cabilla Water Log Jackson
 days well completed firm name county well located

LANDOWNER: <u>Par Point</u> <u>Realty</u>	description of formations encountered	from	to
<u>Ocean Springs Miss</u> (mailing address)			

WELL LOCATION:
 sec. 04 T. 7 N. R. 8 E
4 miles E of Ocean Springs
 (distance) (direction) (nearest town)

CODED

WELL PURPOSE: home
 (home, irrigation, municipal, industrial)

- WELL COMPLETION DATA:
- diameter (inches) 1 1/4
 - total depth (feet) 102
 - static water level (feet) 15 ^{below} above top of ground.
 - casing galv 97
(material) (depth)
1/2 if telescope see back.
(size)
 - screen 5 97
(length) (depth to top)
1 1/4 galv BRASS
(size) (material) 83422
 - pump 1/2 5
(HP) (yield gpm)
Elec
(type power)
 - electric log no
(yes or no)
(organization running log)
 - how well bottom plugged BP Valve


APR 21 1969

MISS. BD. OF
 WATER COMMISSIONERS

DRILLERS REMARKS:
~~...~~

If well telescopes please sketch and show depths.

GROUND LEVEL

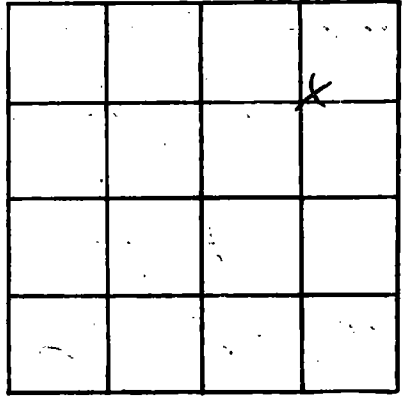

SECTION 24

Please indicate well location X.

ADDITIONAL INFORMATION

If more than one screen, show locations of each on sketch.