

Jackson
 N 230
 5-5-67

MISSISSIPPI
 BOARD OF WATER COMMISSIONERS
 416 North State Street
 Jackson, Mississippi 39201

CODED

WATER WELL DRILLERS LOG

May 5 1962 Colville Water Sup Jackson
 date well completed firm name county well located

LANDOWNER: <u>Barton</u>	description of formations encountered	from	to
<u>Homes</u>			
<u>Propaganda Miss</u> (mailing address)	<u>sand</u> <u>soft blue clay</u> <u>sand</u>	<u>0</u> <u>10</u> <u>10</u> <u>190</u>	<u>10</u> <u>64</u> <u>190</u>
WELL LOCATION:			
sec. <u>23</u> T. <u>7</u> N. R. <u>8</u> E. <u>4</u> miles <u>NE</u> of <u>Ocean Springs</u> (distance) (direction) (nearest town)			
WELL PURPOSE: <u>Home</u> (home, irrigation, municipal, industrial)			
WELL COMPLETION DATA:			
(1) diameter (inches) <u>2</u>			
(2) total depth (feet) <u>190</u>			
(3) static water level (feet) _____ below above top of ground.			
(4) casing <u>galv</u> (material) (depth)			
_____ If telescope see back. (size)			
(5) screen <u>5</u> <u>185</u> (length) (depth to top)			
<u>2</u> <u>stainless</u> (size) (material)			
(6) pump _____ (HP) (yield gpm)			
_____ (type power)			
(7) electric log <u>no</u> (yes or no)			
_____ (organization running log)			
(8) how well bottom plugged <u>B.P. Valve</u>			
DRILLERS REMARKS:			


CODED

APR 21 1969

MISS. BD. OF
 WATER COMM.

If well telescopes please sketch and show depths.

GROUND LEVEL

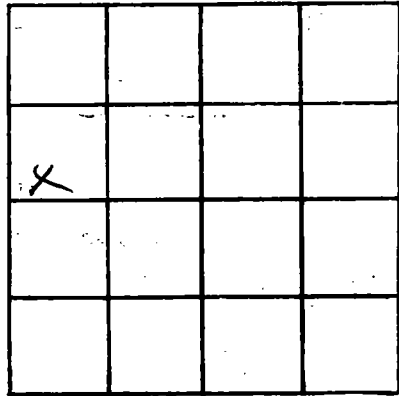

SECTION Q3

Please indicate well location X.

ADDITIONAL INFORMATION

A series of horizontal lines for writing additional information.

If more than one screen, show locations of each on sketch.