

CODED

Jackson
N231
2-28-69

MISSISSIPPI
BOARD OF WATER COMMISSIONERS
416 North State Street
Jackson, Mississippi 39201

WATER WELL DRILLERS LOG

Feb 28 1969 M & B Drilling Co. Jackson
date well completed firm name county well located

LANDOWNER: Terri Wilcox
Amarillo Park
P.O. 3 - Ocean Springs
(mailing address)

WELL LOCATION:
sec. 2 T 7 S R 9 W
1 miles N of Araberville
(distance) (direction) (nearest town)

WELL PURPOSE: Home
(home, irrigation, municipal, industrial)

WELL COMPLETION DATA:

- (1) diameter (inches) 4x2
- (2) total depth (feet)
- (3) static water level (feet) 20 below top of ground
- (4) casing PVC Total
(material) (depth)
4x2 if telescope see back.
(size)
- (5) screen 15 FT
(length) (depth to top)
2" PVC Filter Pac
(size) (material)
- (6) pump 30
(HP) (yield gpm)
220 1/2
(type power)
- (7) electric log No
(yes or no)
(organization running log)
- (8) how well bottom plugged 2" PVC Cap


description of formations encountered	from	to
Surface	0	5
Red Red Brown Clay	5	9
Sand	9	14
Clay	14	20
Sand's Gravel	20	42
Dark Grey Clay + Fine Sand	42	46
Blue Clay	46	52
Coarse Grey Sand leaves clay	52	85
Blue Clay + Block Muck	85	115
Dark Grey Clay	115	185
Blue Clay	185	387
Fine Sand	387	392
Blue Clay	392	508
Fine Sand + Clay pebbles	508	524
Medium Sand	524	542
Blue Clay	542	562
Circulation Loss	300	400

APR 30 1969

DRILLERS REMARKS:

MISS. BD. OF
WATER COMM.

If well telescopes please sketch and show depths.

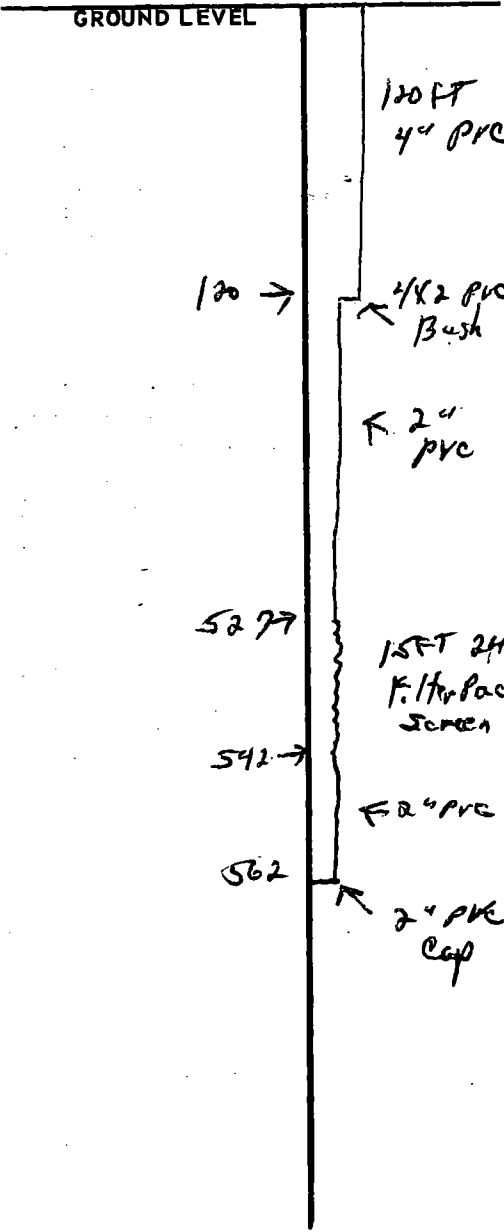

120 →

120 FT
4" PVC

← 4x2 PVC
Bush

← 2"
PVC

5277


15 FT 2H
F. Herbac
Screen

542 →

4x2 PVC

562

← 2" PVC
Cap

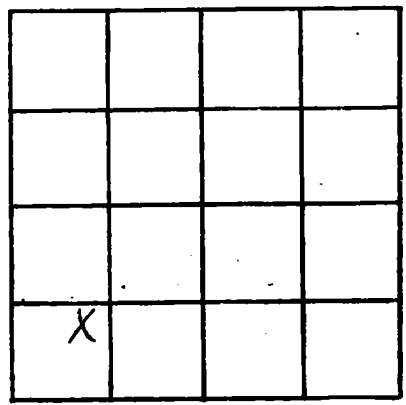

SECTION 2

Please indicate well location X.

ADDITIONAL INFORMATION

If more than one screen, show locations of each on sketch.