

Jackson  
N233  
1-7-69

MISSISSIPPI  
BOARD OF WATER COMMISSIONERS  
416 North State Street  
Jackson, Mississippi 39201

CODED

WATER WELL DRILLERS LOG

Jan 7 1969 L.L. Hasland Jackson  
date well completed firm name county well located

LANDOWNER: H.L. Hickey  
old Highway 90  
O.S. miss  
(mailing address)

description of formations encountered from to

WELL LOCATION:

sec. 14 T. 7 N. R. 9 E.  
3 miles west of O.S.  
(distance) (direction) (nearest town)

WELL PURPOSE: home  
(home, irrigation, municipal, industrial)

WELL COMPLETION DATA:

- (1) diameter (inches) 2 x 4
- (2) total depth (feet) 808
- (3) static water level (feet) 4 below above top of ground.
- (4) casing steel, 778,  
(material) (depth)  
5 1/2" if telescope see back.  
(size)
- (5) screen 30 ft, 778  
(length) (depth to top)  
8 gauge 2", stainless steel  
(size) (material)
- (6) pump 3 1500 gal per  
(HP) (yield gpm) hr.  
electric  
(type power)
- (7) electric log no  
(yes or no)

(organization running log)

(8) how well bottom plugged 2" Valve

DRILLERS REMARKS:


74 ft. sand

FEB 25 1969

MISS. Bd. OF  
WATER COM. REG.

If well telescopes please sketch and show depths.

GROUND LEVEL

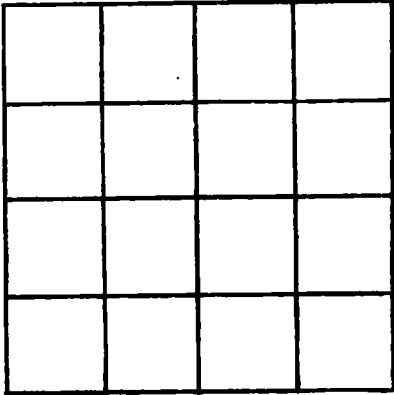

SECTION 14

Please indicate well location X.

ADDITIONAL INFORMATION

Lined area for additional information.

If more than one screen, show locations of each on sketch.