

Jackson  
 N 235  
 4-10-69

MISSISSIPPI  
 BOARD OF WATER COMMISSIONERS  
 416 North State Street  
 Jackson, Mississippi 39201

CODED

WATER WELL DRILLERS LOG

April 10 1969 L.L. Garland, water wells Jackson  
 Date well completed firm name county well located

LANDOWNER: John Switzer  
 410 Ruskin ave  
 Ocean Springs, Miss  
 (mailing address)

description of formations encountered from to

WELL LOCATION:  
 sec 37 T 7 N R 8 E  
 in meters City of Ocean Springs  
 (distance) (direction) (nearest town)

CODED

WELL PURPOSE: Home & Lawn  
 (home, irrigation, municipal, industrial)

WELL COMPLETION DATA:

- (1) diameter (inches) 2"
- (2) total depth (feet) 150 ft
- (3) static water level (feet) 6 below top of ground
- (4) casing steel 144 ft (material) (depth)
- 2 (size) If telescope see back.
- (5) screen 6 ft 144 ft (length) (depth to top)
- gauge 2" L. Steel (size) (material)
- (6) pump 1/2 700 gal. per hr. (HP) (yield gpm)
- electric (type power)
- (7) electric log no (yes or no)

APR 16 1969

MISS. BD. OF WATER COMM.

(organization running log)


(8) how well bottom plugged w. Valve

DRILLERS REMARKS:

30 ft. water bearing sand

If well telescopes please sketch and show depths.

GROUND LEVEL

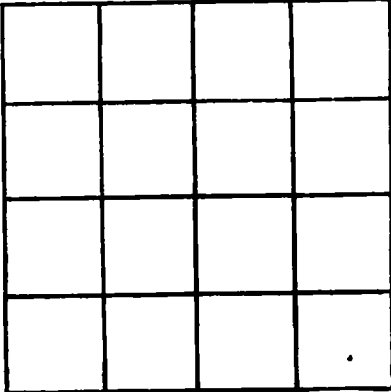

SECTION 37

Please indicate well location X.

ADDITIONAL INFORMATION

A series of horizontal lines for writing additional information.

If more than one screen, show locations of each on sketch.