

CODED

Jackson  
N236  
4-24-69

MISSISSIPPI  
BOARD OF WATER COMMISSIONERS  
416 North State Street  
Jackson, Mississippi 39201

WATER WELL DRILLERS LOG

April 24 1969 L.L. Garland Water Wells Jackson  
date well completed firm name county well located

LANDOWNER: R.D. Riley  
Rt 3 Box 307  
Biloxi, Miss.  
(mailing address)

description of formations encountered from to

WELL LOCATION:  
sec. 1 T 7 N R 9 E  
4 miles N.W. of Os.  
(distance) (direction) (nearest town)

WELL PURPOSE: home  
(home, irrigation, municipal, industrial)

WELL COMPLETION DATA:  
(1) diameter (inches) 2"  
(2) total depth (feet) 346  
(3) static water level (feet) 27 below top of ground  
(4) casing steel, 336 (material) (depth)

2 (size) If telescope see back.  
(5) screen 10, 336 ft (length) (depth to top)  
8 gauge 2", S. Steel (size) (material)  
(6) pump 1/2, 750 gal per hr (HP) (yield gpm)  
electric (type power)

(7) electric log no (yes or no)  
(organization running log)

(8) how well bottom plugged w. valve

DRILLERS REMARKS:  
30 ft. water bearing sand


CODED

APR 30 1969

MISS. Bd. of WATER COMMISSIONERS

If well telescopes please sketch and show depths.

GROUND LEVEL

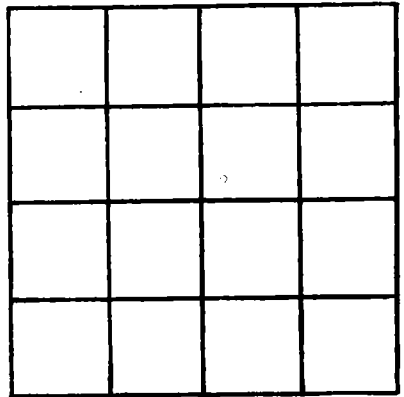

SECTION 1

Please indicate well location X.

ADDITIONAL INFORMATION

A series of horizontal lines for providing additional information.

If more than one screen, show locations of each on sketch.