

CODED

JACKSON  
N 238  
5-26-69

MISSISSIPPI  
BOARD OF WATER COMMISSIONERS  
416 North State Street  
Jackson, Mississippi 39201

WATER WELL DRILLERS LOG

5/26/69 1969 Coastal Drilling Co., Jackson  
date well completed firm name county well located

LANDOWNER Bob Woodruff

RT 1 Cook Rd

Ocean Springs, Miss  
(mailing address)

description of formations encountered

from to

|                   |     |     |
|-------------------|-----|-----|
| Red Clay          | 1   | 10  |
| Sand lite blue    | 10  | 210 |
| hard blue clay    | 210 | 399 |
| Rock              | 399 | 410 |
| fine water sand   | 410 | 420 |
| coarse water sand | 420 | 457 |

WELL LOCATION:

sec 2 T 7 N R 9 E  
S W  
3 miles NB of Biloxi  
(distance) (direction) (nearest town)

WELL PURPOSE: Home  
(home, irrigation, municipal, industrial)

WELL COMPLETION DATA:

- (1) diameter (inches) 2"
- (2) total depth (feet) 457
- (3) static water level (feet) \_\_\_\_\_ below above top of ground.
- (4) casing 2" (material), 457' (depth)  
(size) If telescope see back.
- (5) screen 10' (length), (depth to top)  
2" (size), 38 (material)
- (6) pump 1/2 (HP), 12 (yield gpm)  
Etc (type power)
- (7) electric log (yes or no)

(organization running log)

(8) how well bottom plugged good

DRILLERS REMARKS:

None


CODED

JUN 31 1969

MISS. BD. OF  
WATER COMMISSIONERS

If well telescopes please sketch and show depths.

GROUND LEVEL

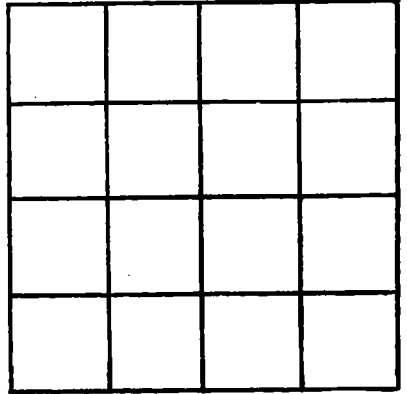

SECTION \_\_\_\_\_

Please indicate well location X.

ADDITIONAL INFORMATION

If more than one screen, show locations of each on sketch.