

Jackson  
N241  
9-19-68

MISSISSIPPI  
 BOARD OF WATER COMMISSIONERS **CODED**  
 416 North State Street  
 Jackson, Mississippi 39201

WATER WELL DRILLERS LOG

Sept 19 1968 L.L. Gaillard Water Wells Jackson  
 date well completed firm name county well located

LANDOWNER: M.D. Jenkins

description of formations encountered from to

Pt. 3 Box 283

Blain, Miss.  
 (mailing address)

WELL LOCATION:

sec. 1 T. 2 N. R. 9 E  
5 W  
4 miles n.w. of P.O.  
 (distance) (direction) (nearest town)

WELL PURPOSE: home  
 (home, irrigation, municipal, industrial)

WELL COMPLETION DATA:

(1) diameter (inches) 2

(2) total depth (feet) 383

(3) static water level (feet) 25 below top of ground.

(4) casing stl, 273  
 (material) (depth)

2" if telescope see back.  
 (size)

(5) screen 11, 273  
 (length) (depth to top)

2", brass  
 (size) (material)

(6) pump no pump  
 (HP) (yield gpm)

(type power)

(7) electric log no  
 (yes or no)

(organization running log)

(8) how well bottom plugged

DRILLERS REMARKS:

30 ft. water bearing sand


**CODED**

FEB 25

MISS. BD. OF WATER COMMISSIONERS

If well telescopes please sketch and show depths.

GROUND LEVEL

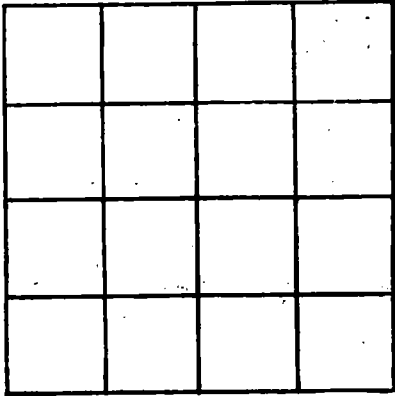

SECTION 1

Please indicate well location X.

ADDITIONAL INFORMATION

Lined area for additional information.

If more than one screen, show locations of each on sketch.