

MISSISSIPPI
BOARD OF WATER COMMISSIONERS
416 North State Street
Jackson, Mississippi 39201

WATER WELL DRILLERS LOG

Jackson
N 242
7-5-69

July 5 1969 L.L. Garland's water wells Jackson
date well completed firm name county well located

LANDOWNER:

Mr. Shannon Trochessett
420 Luave Rd. Biloxi, Miss
(mailing address)

description of formations encountered

from to

WELL LOCATION:

sec. 16 T 7 N R 9 E
3 1/2 miles S.W. of Bil
(distance) (direction) (nearest town)

WELL PURPOSE: home
(home, irrigation, municipal, industrial)

WELL COMPLETION DATA:

- (1) diameter (inches) 2"
- (2) total depth (feet) 273
- (3) static water level (feet) 49 below top of ground. above
- (4) casing steel, 263,
(material) (depth)
2" If telescope see back.
(size)
- (5) screen 10 ft, 263 ft
(length) (depth to top)
8 gauge, stainless steel
(size) (material)
- (6) pump 1/2 750 gal per hr
(HP) (yield gpm)
electric
(type power)
- (7) electric log _____
(yes or no)

(organization running log)

(8) how well bottom plugged Brush valve

DRILLERS REMARKS:


11 ft. water bearing sand

JUL 8 1969

MISS. DEP. OF AGRICULTURE
DIVISION OF WATER

If well telescopes please sketch and show depths.

GROUND LEVEL

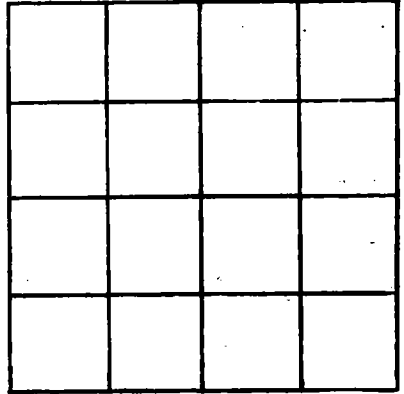

SECTION 16

Please indicate well location X.

ADDITIONAL INFORMATION

If more than one screen, show locations of each on sketch.