

Jackson
 N 245
 4-5-69

CODED

MISSISSIPPI
 BOARD OF WATER COMMISSIONERS
 416 North State Street
 Jackson, Mississippi 39201

WATER WELL DRILLERS LOG

April 5 1969 M+B Drilling Co. Jackson
 (date well completed) (firm name) (county well located)

LANDOWNER: Paul Beere
 Box 496 Biloxi
 (mailing address)

WELL LOCATION:
 sec. 2 T 7 R 9
 S W
 2 miles N of Ocean Springs
 (distance) (direction) (nearest town)

WELL PURPOSE: Home
 (home, irrigation, municipal, industrial)

WELL COMPLETION DATA:
 (1) diameter (inches) 4" x 2"
 (2) total depth (feet) 403
 (3) static water level (feet) 20 below top of ground
 (4) casing PVC 389 FT (material) (depth)
 2" x 2" if telescope see back. (size)
 (5) screen 9 FT 389 (length) (depth to top)
 2" Sand Pac PVC (size) (material)
 (6) pump 1 HP 25 (HP) (yield gpm)
 1/2 Burks Submersible (type power)
 (7) electric log No (yes or no)
 (organization running log)
 (8) how well bottom plugged 2" PVC Cap

description of formations encountered	from	to
Surface	0	15
Black Muck	15	30
Grey Clay	30	65
Sand & Clay Breeds	65	78
Blue Clay	78	125
Limestone	125	129
Blue Clay	129	370
Sand	370	400
Blue Clay	400	403
		+


JUN 2 1969

MISS. DEPT. OF
 WATER COMMISSIONERS

DRILLERS REMARKS:

If well telescopes please sketch and show depths.

GROUND LEVEL

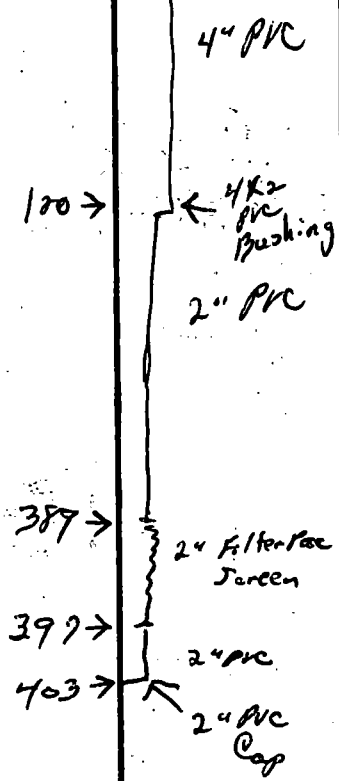

X			

SECTION 2

Please indicate well location X.

ADDITIONAL INFORMATION

If more than one screen, show locations of each on sketch.