

Jackson
N 247
3-26-69

MISSISSIPPI
 BOARD OF WATER COMMISSIONERS
 416 North State Street
 Jackson, Mississippi 39201

CODED

WATER WELL DRILLERS LOG

3-26 1969 Switzer Hall, Co. Jackson
 date well completed firm name county well located

LANDOWNER: E. M. Loper

Washington Avenue
Ocean Springs Drive
 (mailing address)

description of formations encountered	from	to
<u>clay</u>	<u>0</u>	<u>21</u>
<u>mixed</u>	<u>21</u>	<u>143</u>
<u>clay</u>	<u>143</u>	<u>206</u>
<u>mixed</u>	<u>206</u>	<u>248</u>
<u>clay</u>	<u>248</u>	<u>277</u>
<u>fine sand</u>	<u>277</u>	<u>312</u>
<u>clay</u>	<u>312</u>	<u>326</u>
<u>sand</u>	<u>326</u>	<u>330</u>
<u>mixed</u>	<u>330</u>	<u>386</u>
<u>clay</u>	<u>386</u>	<u>415</u>
<u>sand</u>	<u>415</u>	<u>425</u>
<u>fair sand</u>	<u>425</u>	<u>465</u>
<u>good sand</u>	<u>465</u>	<u>528</u>

WELL LOCATION:
 sec. 18 T. 7 N. R. 8 E.
 S W
1 miles N of OCEAN SPRINGS
 (distance) (direction) (nearest town)

WELL PURPOSE: Home
 (home, irrigation, municipal, industrial)

WELL COMPLETION DATA:

- (1) diameter (inches) 2 x 3
- (2) total depth (feet) 522
- (3) static water level (feet) 22 below top of ground.
- (4) casing gal steel, 502,
 (material) (depth)
2 x 3 If telescope see back.
 (size)
- (5) screen 20, 502
 (length) (depth to top)
8 ga., SS on pipe
 (size) (material)
- (6) pump 1/2 overhaul 2.5
 (HP) (yield gpm) more
electric
 (type power)
- (7) electric log No
 (yes or no)

(organization running log)

(8) how well bottom plugged Back pressure valve

DRILLERS REMARKS:

SEP 19 1969


MISS. BD. OF
 WATER COMR.

If well telescopes please sketch and show depths.

GROUND LEVEL

84' of 3"

518' of 2"

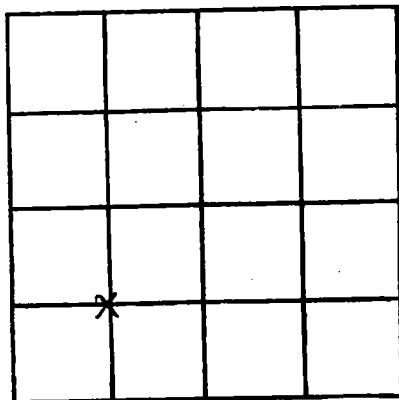

SECTION 18

Please indicate well location X.

ADDITIONAL INFORMATION

If more than one screen, show locations of each on sketch.