

Jackson
 N 248
 5-14-69

MISSISSIPPI
 BOARD OF WATER COMMISSIONERS
 416 North State Street
 Jackson, Mississippi 39201

CODED

WATER WELL DRILLERS LOG

5-14 1969
 date well completed

Switzer Well Co.
 firm name

Jackson
 Harrison
 county well located


LANDOWNER	description of formations encountered	from	to
Randall Ross	Mixed	0	62
Route 3, Box 50	Fair sand	62	82
Biloxi Miss. 39532	sand	82	97
(mailing address)	clay	97	120
WELL LOCATION:	Mixed	120	160
sec. 7 T. 7 N R. 8 E	clay	160	179
1 miles N of OCEAN SPRINGS	Mixed	179	220
(distance) (direction) (nearest town)	clay	220	241
WELL PURPOSE: Home	Mixed	241	263
(home, irrigation, municipal, industrial)	Fair sand	263	293
WELL COMPLETION DATA:			
(1) diameter (inches) 2			
(2) total depth (feet) 293			
(3) static water level (feet) 25 below top of ground.			
(4) casing gal steel 283' (material) (depth)			
2" If telescope see back. (size)			
(5) screen 10' 283' (length) (depth to top)			
8 gpm 55 on pipe (size) (material)			
(6) pump not installed (HP) (yield gpm)			
(type power)			
(7) electric log No (yes or no)			
(organization running log)			
(8) how well bottom plugged Back pressure valve			
DRILLERS REMARKS:			

SEP 19 1969

MISS. BD. OF WATER COM. S

If well telescopes please sketch and show depths.

GROUND LEVEL

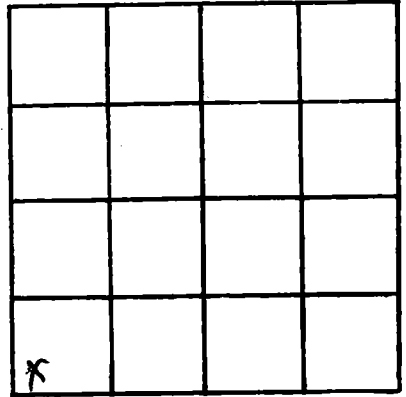

SECTION 7

Please indicate well location X.

ADDITIONAL INFORMATION

If more than one screen, show locations of each on sketch.