

CODED

JACKSON  
N 251  
11-21-69

MISSISSIPPI  
BOARD OF WATER COMMISSIONERS  
416 North State Street  
Jackson, Mississippi 39201

WATER WELL DRILLERS LOG

nov 21 1969 L.L. Garland Water Wells Jackson  
date well completed firm name county well located

LANDOWNER: Lamar Poole  
#8 Forest Hills Dr  
Ocean Springs Miss  
(mailing address)

description of formations encountered from to

WELL LOCATION:  
sec. 12 T 7 N R 4 E  
3 miles north of R.L.  
(distance) (direction) (nearest town)

WELL PURPOSE: home  
(home, irrigation, municipal, industrial)

- WELL COMPLETION DATA:
- (1) diameter (inches) 2"
  - (2) total depth (feet) 147
  - (3) static water level (feet) 26 <sup>below</sup> <sub>above</sub> top of ground.
  - (4) casing s. steel 141 ft  
(material) (depth)  
2 (size) if telescope see back.
  - (5) screen ~~4 1/2 ft~~ 141 ft  
(length) (depth to top)  
2" stainless steel  
(size) (material)
  - (6) pump customer's own  
(HP) (yield gpm)  
pump  
(type power)
  - (7) electric log \_\_\_\_\_  
(yes or no)  
\_\_\_\_\_  
(organization running log)
  - (8) how well bottom plugged wood valve


NOV 26 1969

DRILLERS REMARKS:  
18 ft water  
blowing sand

Miss. Bd. of  
Water Comm.

If well telescopes please sketch and show depths.

GROUND LEVEL

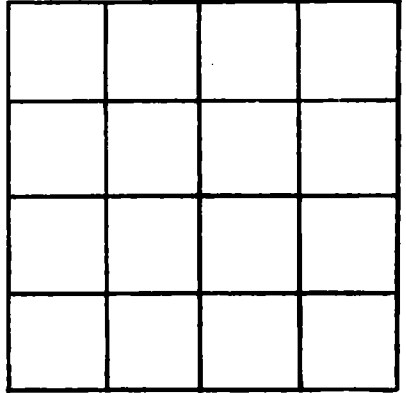

SECTION \_\_\_\_\_

Please indicate well location X.

ADDITIONAL INFORMATION

If more than one screen, show locations of each on sketch.