

Jackson
 N 257
 12-3-69

MISSISSIPPI
 BOARD OF WATER COMMISSIONERS
 416 North State Street
 Jackson, Mississippi 39201

CODED

CODED

WATER WELL DRILLERS LOG

12-3-69 date well completed
 RT MOORE firm name
 JACKSON county well located

LANDOWNER: Verdey Fenoma
176 Reynoir St
Biloxi Miss.
 (mailing address)

description of formations encountered	from	to
SURFACE SOIL	0	41
WHITE SAND	41	55
BLUE CLAY	55	72
FINE SAND	72	95
Blue clay	95	284
Blue Sand	284	304

WELL LOCATION:
 sec. 16 T 7 N R 9 E
176 REYNOR ST BILOXI, MISS
 (distance) miles (direction) of (nearest town)

WELL PURPOSE:
 (home, irrigation, municipal, industrial)

- WELL COMPLETION DATA:
- diameter (inches) 2"
 - total depth (feet) 304'
 - static water level (feet) 30' below top of ground
 - casing galv 294'
 (material) (depth)
 (size) if telescope see back.
 - screen 2x10 294'
 (length) (depth to top)
2" SS
 (size) (material)
 - pump 1 600 GPM
 (HP) (yield gpm)
ELC
 (type power)
 - electric log (yes or no)
 - (organization running log)
 - how well bottom plugged B.W.
W.H. Va.


DRILLERS REMARKS:

JAN - 9 1969

MISS. BU. OF WATER COMMISSIONERS

If well telescopes please sketch and show depths.

GROUND LEVEL

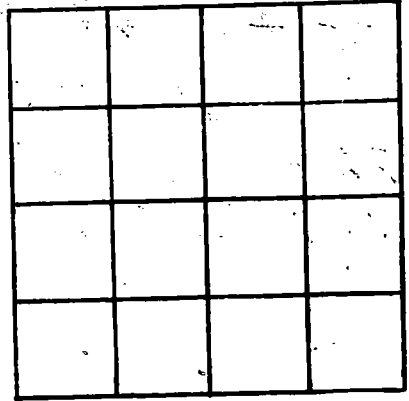

SECTION 16

Please indicate well location X.

ADDITIONAL INFORMATION

If more than one screen, show locations of each on sketch.