

~~Plan 1/26/70~~ info
Low bank 11/26/70

MISSISSIPPI
BOARD OF WATER COMMISSIONERS
416 North State Street
Jackson, Mississippi 39201

CODED

WATER WELL DRILLERS LOG

CODED

Jackson
N 258
11-4-69

11/4/69 1969 Coastal Drilling Jackson
date well completed firm name county well located

LANDOWNER Overton Allen
1016 Lee St
Ridgely, Miss
(mailing address)

WELL LOCATION:
sec. 11 T. 7 N. R. 9 E
S. W.
one miles NW Jolly Hill
(distance) (direction) (nearest town)

WELL PURPOSE: Home
(home, irrigation, municipal, industrial)

WELL COMPLETION DATA:
(1) diameter (inches) 2"
(2) total depth (feet) 472
(3) static water level (feet) 38 below above
top of ground.
(4) casing galv 472
(material) (depth)
(size) if telescope see back.
(5) screen 10' 462'
(length) (depth to top)
2" SS
(size) (material)
(6) pump 1 HP 21
(HP) (yield gpm)
Elc
(type power)
(7) electric log NO
(yes or no)
(organization running log)
(8) how well bottom plugged BW
good

description of formations encountered	from	to
<u>white sand</u>	<u>1</u>	<u>10</u>
<u>Red clay</u>	<u>10</u>	<u>25</u>
<u>Coarse white sand</u>	<u>25</u>	<u>40</u>
<u>Seagull sand</u>	<u>40</u>	<u>70</u>
<u>white sand</u>	<u>70</u>	<u>85</u>
<u>Blue clay</u>	<u>85</u>	<u>380</u>
<u>Shell</u>	<u>380</u>	<u>383</u>
<u>fine water sand</u>	<u>383</u>	<u>404</u>
<u>Coarse water sand</u>	<u>404</u>	<u>472</u>

JAN 12 1970


DRILLERS REMARKS:

None

MISS. BD. OF
WATER CO.

If well telescopes please sketch and show depths.

GROUND LEVEL

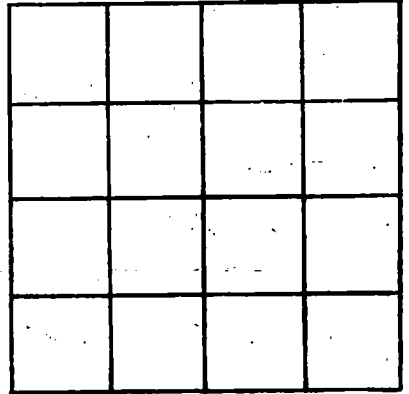

SECTION _____

Please indicate well location X.

ADDITIONAL INFORMATION

If more than one screen, show locations of each on sketch.