

Jackson  
 N 259  
 11-17-69

MISSISSIPPI  
 BOARD OF WATER COMMISSIONERS  
 416 North State Street  
 Jackson, Mississippi 39201

CODED

WATER WELL DRILLERS LOG

CODED

11/17/69 date well completed      1969 Coastal Drilling firm name      Jackson county well located

LANDOWNER: Larry Halladay  
Pt 3 Box 314  
Osborn, Spring, Miss  
 (mailing address)

description of formations encountered	from	to
white sand	1	10
red clay	10	25
white sand	25	40
gray sand	40	70
white sand	70	85
blue clay	85	380
shell	380	383
fine water sand	383	404
course water sand	404	477

WELL LOCATION:  
 sec. 11 T. 7 N. R. 9 E  
One miles NW of Hill Hill  
 (distance) (direction) (nearest town)

WELL PURPOSE: home  
 (home, irrigation, municipal, industrial)

WELL COMPLETION DATA:

(1) diameter (inches) 2"

(2) total depth (feet) 465

(3) static water level (feet) 38 below above top of ground.

(4) casing galv. 455  
 (material) (depth)  
   If telescope see back.  
 (size)

(5) screen 10' 455  
 (length) (depth to top)  
galv. SS  
 (size) (material)

(6) pump 1HP 19  
 (HP) (yield gpm)  
ele  
 (type power)

(7) electric log NO  
 (yes or no)

   (organization running log)

(8) how well bottom plugged BN  
good


JAN 12 1970

MISS. DD  
 WAT

DRILLERS REMARKS:  
none

If well telescopes please sketch and show depths.

GROUND LEVEL

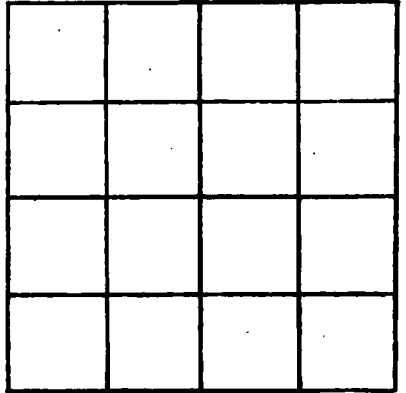

SECTION \_\_\_\_\_

Please indicate well location X.

ADDITIONAL INFORMATION

If more than one screen, show locations of each on sketch.