

Jackson
 N 260
 12-5-69

MISSISSIPPI
 BOARD OF WATER COMMISSIONERS
 416 North State Street
 Jackson, Mississippi 39201

CODED
 CODED

WATER WELL DRILLERS LOG

12/15/69 19 Central Drilling Co Jackson
 date well completed firm name county well located

LANDOWNER Donald R Buxton
Rt 2 Box 190A
Bitoni, Miss
 (mailing address)

description of formations encountered	from	to
Clay	6	8
Clay	8	72
White Sand	72	27
hard Blue Clay	27	144
fine water sand	144	179
Coarse water sand	179	192

WELL LOCATION:
 sec 11 T 7 N R 9 E
7 miles NW of Gulf Hill
 (distance) (direction) (nearest town)

WELL PURPOSE: home
 (home, irrigation, municipal, industrial)

WELL COMPLETION DATA:

(1) diameter (inches) 2"

(2) total depth (feet) 192

(3) static water level (feet) 8' below top of ground

(4) casing galv 182
 (material) (depth)
 (size) if telescope see back.

(5) screen 10' 182
 (length) (depth to top)
2" 38
 (size) (material)

(6) pump _____
 (HP) (yield gpm)
 (type power)

(7) electric log no
 (yes or no)

(organization running log)

(8) how well bottom plugged
2" back wash valve


DRILLERS REMARKS:
None

JAN 26 1970

MISS. BD. OF
 WATER COMM.

If well telescopes please sketch and show depths.

GROUND LEVEL

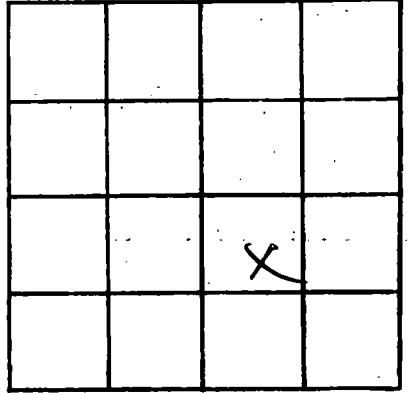

SECTION 11

Please indicate well location X.

ADDITIONAL INFORMATION

A series of horizontal lines for writing additional information.

If more than one screen, show locations of each on sketch.