

Jackson
 N261
 12-20-69

MISSISSIPPI
 BOARD OF WATER COMMISSIONERS
 416 North State Street
 Jackson, Mississippi 39201

CODED
 CODED

WATER WELL DRILLERS LOG

12/20/69 19 Coastal Drilling Jackson
 date well completed firm name county well located

LANDOWNER: Harold Basorge Rt 3 Bolivar
 Bi-Loxi, Miss
 (mailing address)

description of formations encountered	from	to
Red Clay	1	5
White Sand	5	29
glau	29	35
White Sand	35	60
fine water sand	60	120
Blue Clay	120	126
fine water sand	120	182
fine water sand	182	199

WELL LOCATION:
 sec 15 T 7 N S R 9 E W
 2 miles W of Gulf Hills
 (distance) (direction) (nearest town)

WELL PURPOSE: home
 (home, irrigation, municipal, industrial)

WELL COMPLETION DATA:
 (1) diameter (inches) 2"
 (2) total depth (feet) 199
 (3) static water level (feet) 7 below top of ground
 (4) casing glau 189 (material) (depth)
 (size) if telescope see back.
 (5) screen 10' 189 (length) (depth to top)
 2" SS (size) (material)
 (6) pump (HP) (yield gpm)
 (type power)
 (7) electric log 7W (yes or no)
 (organization running log)


JAN 26 1970

(8) how well bottom plugged
 2" hard work value
 DRILLERS REMARKS:

MISS. BD. OF
 WATER COMMISSIONERS

If well telescopes please sketch and show depths.

GROUND LEVEL

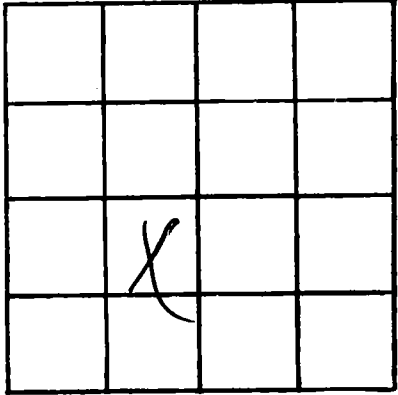

SECTION 15

Please indicate well location X.

ADDITIONAL INFORMATION

Lined area for additional information.

If more than one screen, show locations of each on sketch.