

MISSISSIPPI
BOARD OF WATER COMMISSIONERS
416 North State Street
Jackson, Mississippi 39201



WATER WELL DRILLERS LOG

JACKSON
N 263
2-11-70

Feb 11 1970 L.S. Hancock Water Wells Jackson
date well completed firm name county well located

LANDOWNER: Sidney Skinner

description of formations encountered from to

Highway # 90 East
Ocean Springs, Miss
(mailing address)

WELL LOCATION:

sec 26 T. 7 N R. 8 E
5 miles east of D.D.
(distance) (direction) (nearest town)

WELL PURPOSE: Home
(home, irrigation, municipal, industrial)

WELL COMPLETION DATA:

- (1) diameter (inches) 2"
- (2) total depth (feet) 304
- (3) static water level (feet) 9 ^{below}/_{above} top of ground.
- (4) casing steel, 294ft
(material) (depth)
2 if telescope see back.
(size)
- (5) screen 10ft, 294ft
(length) (depth to top)
2", stainless steel
(size) (material)
- (6) pump 1/2 550 gal per hr.
(HP) (yield/gpm)
electric
(type power)
- (7) electric log _____
(yes or no)

(organization running log)

(8) how well bottom plugged Back
Wash Valve


DRILLERS REMARKS:
42 ft. water
blowing sand

FEB 13 1970

MISS. BO. OF WATER COMM

If well telescopes please sketch and show depths.

GROUND LEVEL

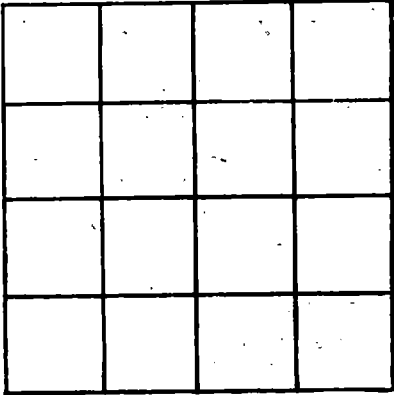

SECTION _____

Please indicate well location X.

ADDITIONAL INFORMATION

Lined area for additional information.

If more than one screen, show locations of each on sketch.