

Jackson

N 264

2-20-70

MISSISSIPPI
 BOARD OF WATER COMMISSIONERS
 416 North State Street
 Jackson, Mississippi 39201

CODED

WATER WELL DRILLERS LOG

Feb 20 1970
date well completed

L.S. Oakland Water Wells Jackson
firm name county well located

LANDOWNER: J.C. McKenzie

Box 402, Sunset Blvd.

Ocean Springs, Miss.
(mailing address)

WELL LOCATION:

sec 18 T 7 N R 8 E
 2 1/2 miles north of O.S.
 (distance) (direction) (nearest town)

WELL PURPOSE: Home
(home, irrigation, municipal, industrial)

WELL COMPLETION DATA:

- (1) diameter (inches) 2"
- (2) total depth (feet) 483
- (3) static water level (feet) 9 ^{below}/_{above} top of ground.
- (4) casing steel, 467, (material) (depth)
2 (size) If telescope see back.
- (5) screen 16 ft, 467 (length) (depth to top)
2" stainless steel (size) (material)
- (6) pump (HP) (yield gpm)
Customer has
- (7) electric log own pump (yes or no)

(organization running log)

(8) how well bottom plugged Back wash valve

DRILLERS REMARKS:

49 ft water bearing sand

description of formations encountered

from


to

FEB 27 1970

MISS. BD. OF WATER COMM.

If well telescopes please sketch and show depths.

GROUND LEVEL

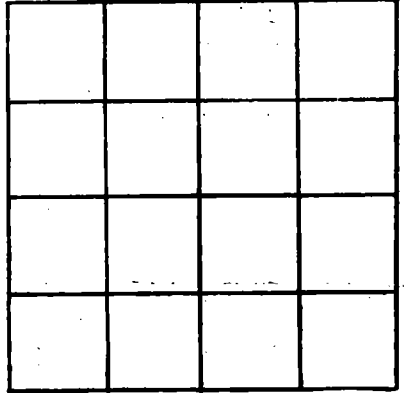

SECTION _____

Please indicate well location X.

ADDITIONAL INFORMATION

If more than one screen, show locations of each on sketch.