

Jackson

N 266

3-27-69

MISSISSIPPI
 BOARD OF WATER COMMISSIONERS
 416 North State Street
 Jackson, Mississippi 39201

WATER WELL DRILLERS LOG

CODED

3/27

date well completed

19 Coastal Drilling Co.

firm name

Madison

county well located

LANDOWNER

Evander Hill

description of formations encountered

from to

1012 Spunk Dr.

Olson Spring, Miss.
(mailing address)

Sand	1	15
White Sand	15	37
Gravel	37	50
Blue Clay	50	207
fine water sand	207	219
clay	219	235
fine water sand	235	255
coarse water sand	255	270
run coarse water sand	270	314

WELL LOCATION:

sec. 19 T. 7 N. R. 9 E.
 Gulf Hill Ridge
 (distance) miles (direction) of (nearest town)

WELL PURPOSE: none
(home, irrigation, municipal, industrial)

WELL COMPLETION DATA:

- (1) diameter (inches) 2"
- (2) total depth (feet) 314
- (3) static water level (feet) 7 below above top of ground
- (4) casing galv. 304
(material) (depth)
(size) If telescope see back.
- (5) screen 10' 304
(length) (depth to top)
2" SS
(size) (material)
- (6) pump 1 HP 19
(HP) (yield gpm)
Elc
(type power)
- (7) electric log no
(yes or no)
no
(organization running log)

CODED

(8) how well bottom plugged
2" galv. water pipe


DRILLERS REMARKS:
none

APR - 1 1970

MISS. BD. OF
WATER COMMISSIONERS

If well telescopes please sketch and show depths.

GROUND LEVEL

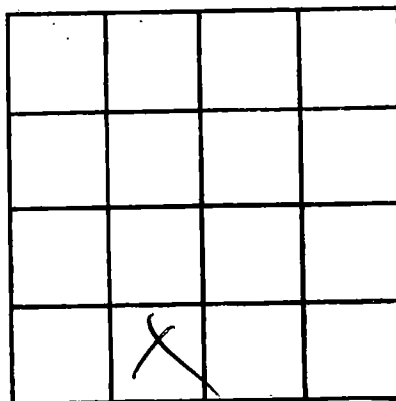

SECTION 19

Please indicate well location X.

ADDITIONAL INFORMATION

If more than one screen,
show locations of each on sketch.