

Jackson
 N 267
 3-14-70

MISSISSIPPI
 BOARD OF WATER COMMISSIONERS
 416 North State Street
 Jackson, Mississippi 39201

CODED

WATER WELL DRILLERS LOG

3/14/70 date well completed
 Coastal Drilling Co. firm name
 Harrison county well located

LANDOWNER: L. W. Donald
87 1/2 St.
Oliver Springs, Miss
 (mailing address)

description of formations encountered	from	to
White Sand	1	10
Red Clay	10	23
Black Sand	23	40
Soft Blue Clay	40	260
Fire Water Sand	260	280
Coarse white sand	280	307

WELL LOCATION:
 sec. 7 T. 9 S. R. 8
None miles N of Shiloh
 (distance) (direction) (nearest town)

WELL PURPOSE:
 (home, irrigation, municipal, industrial)
None

WELL COMPLETION DATA:

(1) diameter (inches) 2"

(2) total depth (feet) 307

(3) static water level (feet) 16 below top of ground

(4) casing Galv - 297
 (material) (depth)
7/8" (size) If telescope see back.

(5) screen 10' 297
 (length) (depth to top)
2" SS
 (size) (material)

(6) pump 1/3 12
 (HP) (yield gpm)
elec
 (type power)

(7) electric log no
 (yes or no)
no
 (organization running log)

CODED

(8) how well bottom plugged
2 feet water seal


DRILLERS REMARKS:
no

APR - 1 1970

MISS. BD. OF
 WATER COMM.

If well telescopes please sketch and show depths.

GROUND LEVEL

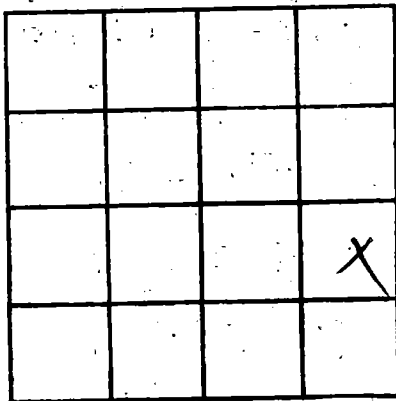

SECTION 7

Please indicate well location X.

ADDITIONAL INFORMATION

If more than one screen, show locations of each on sketch.