

Jackson
 N 268
 4-19-70

MISSISSIPPI
 BOARD OF WATER COMMISSIONERS
 416 North State Street
 Jackson, Mississippi 39201
 WATER WELL DRILLERS LOG

CODED

4-19-70 date well completed
 Coast Water Well Service firm name
 Jackson county well located

LANDOWNER: Redney J. Budnick
Ocean Springs East
Highway 90
 (mailing address)
 WELL LOCATION: 158
 sec. 26 T. 7 N. R. 8 W.
4 miles E. of Ocean Springs
 (distance) (direction) (nearest town)

description of formations encountered	from	to
<u>Red Clay</u>	<u>0</u>	<u>12</u>
<u>Sand - coarse to fine</u>	<u>12</u>	<u>84</u>
<u>Blue Clay + streaks sand</u>	<u>84</u>	<u>262</u>
<u>Sand - fine to med.</u>	<u>262</u>	<u>293</u>
<u>Blue Clay</u>	<u>293</u>	<u>378</u>
<u>Sand - fine to med.</u>	<u>378</u>	<u>451</u>

WELL PURPOSE: Home
 (home, irrigation, municipal, industrial)


WELL COMPLETION DATA:
 (1) diameter (inches) 2"
 (2) total depth (feet) 450'
 (3) static water level (feet) 21 below above top of ground.
 (4) casing galv. 440'
 (material) (depth)
2" if telescope see back.
 (size)
 (5) screen 10' 440'
 (length) (depth to top)
2" Strainers
 (size) (material)
 (6) pump 1 10
 (HP) (yield gpm)
elec.
 (type power)
 (7) electric log NO
 (yes or no)
 (organization running log)
 (8) how well bottom plugged Back-
 Wash Valve

MAY 21 1970
 MISS. BD. OF
 WATER COMMISSIONERS

DRILLERS REMARKS:

If well telescopes please sketch and show depths.

GROUND LEVEL

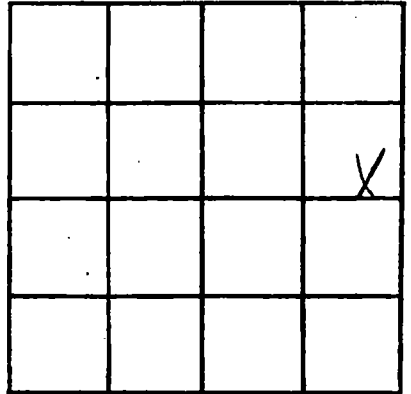

SECTION 26

Please indicate well location X.

ADDITIONAL INFORMATION

If more than one screen,
show locations of each on sketch.