

MISSISSIPPI
BOARD OF WATER COMMISSIONERS
416 North State Street
Jackson, Mississippi 39201

CODED

WATER WELL DRILLERS LOG


Jackson
N 269
4-29-70

4-29 1970 Coast Water Well Service Jackson
date well completed firm name county well located

LANDOWNER: <u>Gen-Plex Div.</u>	description of formations encountered	from	to
<u>P.O. Box 4527</u>			
<u>Jackson, Miss.</u> (mailing address)	<u>Top Soil</u>	<u>0</u>	<u>11</u>
	<u>Sand - Med to coarse</u>	<u>11</u>	<u>130</u>
	<u>Blue Clay</u>	<u>130</u>	<u>185</u>
	<u>Sand - Med to coarse</u>		
	<u>Sand - Fine to Med.</u>	<u>185</u>	<u>215</u>
WELL LOCATION: <u>158</u>			
sec. <u>3</u> T. <u>7</u> S. R. <u>8</u> W.			
<u>5</u> miles <u>NE</u> of <u>Ocean Springs</u> (distance) (direction) (nearest town)			
WELL PURPOSE: <u>I-10 construction</u> (home, irrigation, municipal, industrial)			
WELL COMPLETION DATA:			
(1) diameter (inches) <u>2"</u>			
(2) total depth (feet) <u>215'</u>			
(3) static water level (feet) <u>30</u> below above top of ground.			
(4) casing <u>galv.</u> <u>205'</u> (material) (depth) <u>2"</u> (size) if telescope see back.			
(5) screen <u>10'</u> <u>205'</u> (length) (depth to top) <u>2"</u> <u>Stainless Steel</u> (size) (material)			
(6) pump _____ (HP) (yield gpm) (type power)			
(7) electric log <u>No</u> (yes or no) (organization running log)			
(8) how well bottom plugged <u>Brickwash</u> <u>Value</u>			
DRILLERS REMARKS:			

If well telescopes please sketch and show depths.

GROUND LEVEL

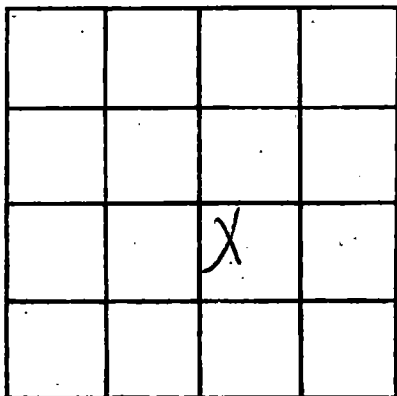

SECTION 3

Please indicate well location X.

ADDITIONAL INFORMATION

If more than one screen,
show locations of each on sketch.