

Jackson
N 270
5-10-70

MISSISSIPPI
BOARD OF WATER COMMISSIONERS
416 North State Street
Jackson, Mississippi 39201

WATER WELL DRILLERS LOG

CODED

May 10 1971 L.L. Garland, Water Wells Jackson
date well completed firm name county well located

LANDOWNER: Arnold Parker,

description of formations encountered

from to

P.O. Box 718

Olean Springs, miss.
(mailing address)

WELL LOCATION:

sec 23 T 7 N R 8 E
5 miles East of Ard.
(distance) (direction) (nearest town)

WELL PURPOSE: home
(home, irrigation, municipal, industrial)

WELL COMPLETION DATA:

- (1) diameter (inches) 2
- (2) total depth (feet) 462
- (3) static water level (feet) 19 (below top of ground)
- (4) casing steel, 452, (material) (depth)
2" If telescope see back.
(size)
- (5) screen 10 ft, 452 (length) (depth to top)
2" stainless steel
(size) (material)
- (6) pump 1/2 (HP) 550 gal per hr.
yield gpm
electric
(type power)
- (7) electric log _____
(yes or no)

MAY 18 1970

MISS. BD. OF
WATER COMM


- (8) how well bottom plugged
back wash valve

DRILLERS REMARKS:

46 ft Water bearing
sand

If well telescopes please
sketch and show depths.

GROUND LEVEL

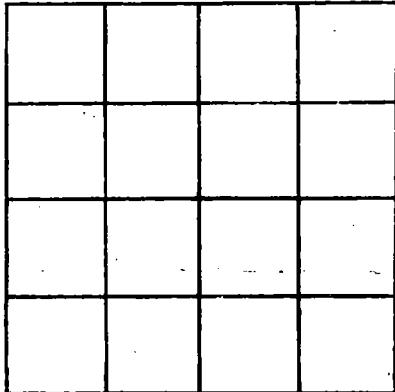

SECTION _____

Please indicate well location X.

ADDITIONAL INFORMATION

If more than one screen,
show locations of each on sketch.