

Jackson
 N 272
 5-9-70

MISSISSIPPI
 BOARD OF WATER COMMISSIONERS
 416 North State Street
 Jackson, Mississippi 39201

CODED

WATER WELL DRILLERS LOG

5-9-70 date well completed
 Central Drilling Co. firm name
 Jackson county well located

LANDOWNER: Melvin Clark
 Rt 1 Box 707
 Ocean Springs, Miss
 (mailing address)

description of formations encountered	from	to
Top soil	1	5
White Sand	5	15
Red Clay	15	22
Shale	22	27
White Sand	27	47
fine water sand	47	102
fine water sand	102	341
fine water sand	341	352

WELL LOCATION:
 sec. 11 T 7 N R 9 E
 (2) 7/10 miles N (distance) (direction) Gulfbluffs (nearest town)

WELL PURPOSE: none
 (home, irrigation, municipal, industrial)

WELL COMPLETION DATA:
 (1) diameter (inches) 2"
 (2) total depth (feet) 352
 (3) static water level (feet) 40 below top of ground
 (4) casing Galv. 342 (material) (depth)
 (size) If telescope see back.
 (5) screen 10' 342 (length) (depth to top)
 2" 58 (size) (material)
 (6) pump 1 HP 12 (HP) (yield gpm)
 ELL (type power)
 (7) electric log no (yes or no)
 (organization running log)


(8) how well bottom plugged
 2" back wash water
 DRILLERS REMARKS:
 None

MAY 11 1970

MISS. Bd. of WA. Co.

If well telescopes please sketch and show depths.

GROUND LEVEL

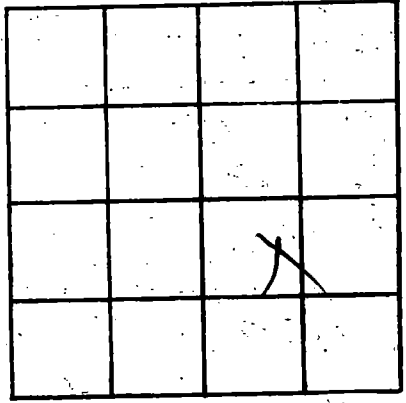

SECTION _____

Please indicate well location X.

ADDITIONAL INFORMATION

If more than one screen, show locations of each on sketch.